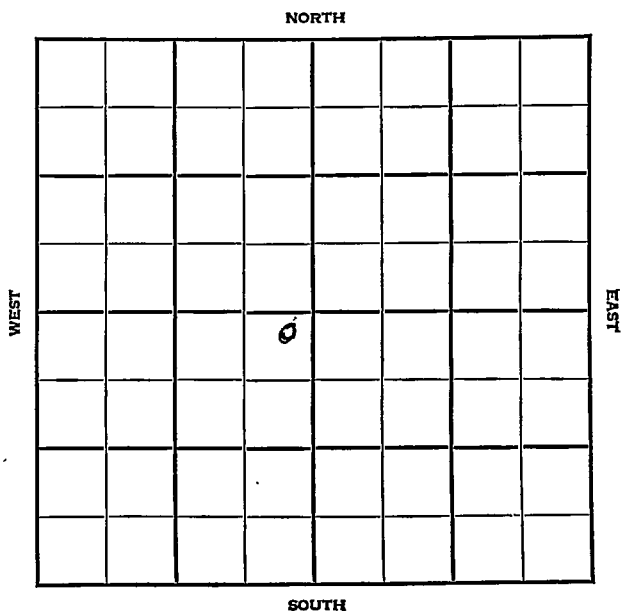



Section 30 Township 32 Range 34WWell No. #1 HitchCompany Cities Service

KANSAS

Seward

Sec. 30 Twp. 32 R. 34WWell No. #1 Hitch FarmCities Service Company

Hugoton

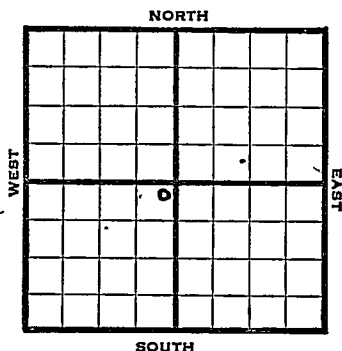100 Ft. from N. Line Ft. from S. Line100 Ft. from E. Line Ft. from W. Line

NE SW

1947 Elev. 2942' REPORT

10/8 Location

10/15 8" @ 800'
WOC

10/22 Drlg. 1490'

10/29 TD 2785'
5" @ 2784'
RUST

11/5 "

11/12 140 shots. 2678-2806'
170 shots. 2630-64'
30 shots. 2610-16'
60 shots. 2574-84' - 29000 acid.

11/19 "

11/25 "

12/3 5" @ 2784'
Perf.
Acid 29,000
17 M Gas
R. Fr. 411#
Total Depth 2785'
COMPLETED

Map No. _____ Sec. ⁹ 30 Twp. 32 R. 34W

Well No. 1 Hitch

_____ Cities Service _____ Company

FIRST REPORT

_____ Contractor

NE SW


SECTION PLAT

100 Ft. from N. Line

_____ Ft. from S. Line

100 Ft. from E. Line

_____ Ft. from W. Line

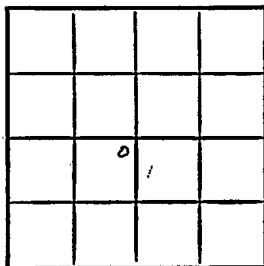

Seward County

Location X

Rig up

Drilling and Remarks:

RECORD

Cased _____ in., _____ ft.

Sand _____

Gas _____

Oil _____

Total Depth _____

PRODUCTION

1st 24 hrs. Nat. _____

1st 24 hrs. after shot _____

Gas _____ Cu. Ft.

Dry Hole _____

Abandoned _____

Date

OCT 8 - 1947

19

S. J. LEWIS

Scout

Map No. _____ Sec. 30 Twp. 32 R. 34W

Well No. 1 Hitch

_____ Cities Service _____ Company

COMPLETE

_____ Contractor

NE SW


E12942
SECTION PLAT

100 Ft. from N. Line

_____ Ft. from S. Line

100 Ft. from E. Line

_____ Ft. from W. Line

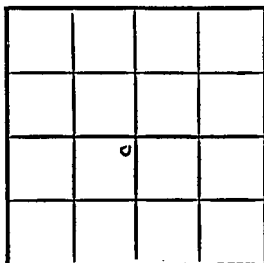

Seward County

Location _____

Rig up _____

Drilling and Remarks:

5' @ 2784

Prof.

29000 acs/c

17 M Gas

*411 * R/A*

RECORD

Cased _____ in., _____ ft.

Sand _____

Gas _____

Oil _____

Total Depth 2785

PRODUCTION

1st 24 hrs. Nat. _____

1st 24 hrs. after shot _____

Gas _____ Cu. Ft.

Dry Hole _____

Abandoned _____

Date

DEC 3 1947 19 S. J. LEWIS Scout