

KANSAS

Seward


Section 32 Township 32 Range 34W

Well No. 1 Hitch "H"

Company Cities' Service

Hugoton Pool

NORTH

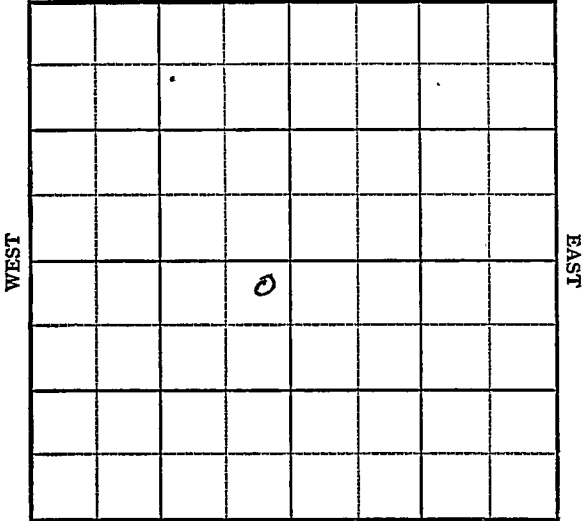

SOUTH

KANSAS

Seward

Sec. 32 Twp. 32 R. 34-W ✓

Well No. #1 Hitch "H" Farm _____

Cities Service

Hugoton

Company _____


100 Ft. from N. Line

_____ Ft. from S. Line

100 Ft. from E. Line

_____ Ft. from W. Line

NE SW

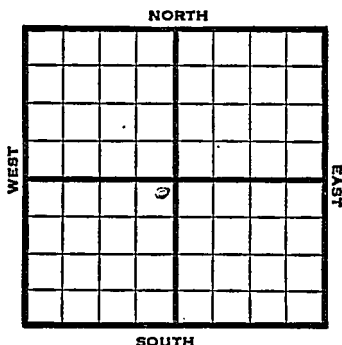

1949 Elev 2911' REPORT

1/28 RUR
2/2 "
2/9 8" @ 600'
Drlg 2260'

2/16 TD 2735'
5" @ 2734'

2/23 36 shots 2627-36'
64 " 2600-16'
20 " 2700-07'
27 " 2638-46'

3/2 29,000 acid
3/8 "
3/16 TD 2735'
5" @ 2734'
Perf 29000 acid
10,900,000 Gas
413# R Pr.
Bomp

COMPLETED

Map No. _____ Sec. 32 Twp. 32 R. 34W

Well No. 1 Hitch "H"

_____ Cities Service _____ Company

FIRST REPORT

_____ Contractor

NE SW


SECTION PLAT

100 Ft. from N. Line

_____ Ft. from S. Line

100 Ft. from E. Line

_____ Ft. from W. Line

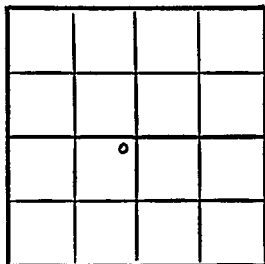

Seward County

Location _____

Rig up _____

Drilling and Remarks:

R U R

RECORD

Cased _____ in., _____ ft.

Sand _____

Gas _____

Oil _____

Total Depth _____

PRODUCTION.

1st 24 hrs. Nat. _____

1st 24 hrs. after shot _____

Gas _____ Cu. Ft.

Dry Hole _____

Abandoned _____

Date

JAN 26 1949

19

S. J. LEWIS Scout

Kansas

Map No. _____ Sec. 32 Twp. 32 R. 34WWell No. 1 Hitch "H"


Cities Service

Company

COMPLETE

Contractor

NE SW

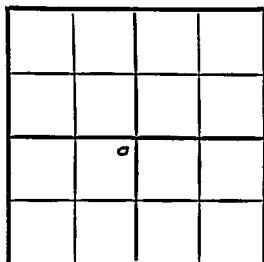E1.2911
SECTION PLAT100 Ft. from N. Line Ft. from S. Line100 Ft. from E. Line Ft. from W. Line

Seward County

RECORD

Location _____

Cased _____ in., _____ ft.

Rig up _____

Sand _____

Drilling and Remarks:

Gas _____

Oil _____

Total Depth 2225

PRODUCTION

1st 24 hrs. Nat. _____

1st 24 hrs. after shot _____

Gas _____ Cu. Ft.

Dry Hole _____

Abandoned _____

Date

MAR 16 1949

19

S. J. LEWIS

Scout

5" C2734

Perf.

29000 acid

10,500,000 gal

HIS R. P.