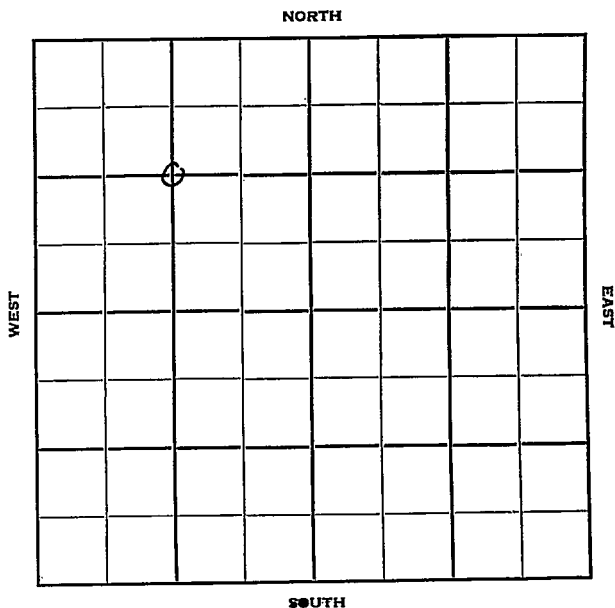


Section 36 Township 32 Range 34-WWell No. #1 BaughmanCompany Cabot Carbon

KANSAS

Seward

Sec. 36 Twp. 32 R. 34-W ✓

Well No. #1 Baughman Farm

Cabot Carbon Company

Contractor

Hugoton

1320

Ft. from N. Line


Ft. from S. Line

Ft. from E. Line

1320

Ft. from W. Line

C NW/4

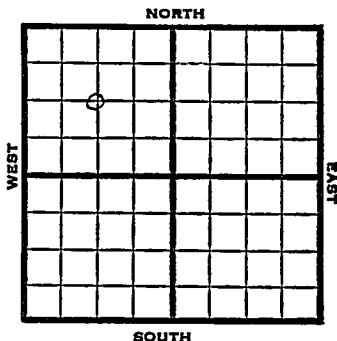

1951

Elev. 2896'

REPORT

1/3

Spud 12-16-50

10" @ 476

TD 2616'

3/14

Spud 12-16-50

Gas well

TD 2696'

10" @ 476,

7" @ 2598,

TD 2696'

Her. 2600,

Krider 2620,


Win. 2684,

22,000 A

Comp. 17,000,000 gas

397#

COMPLETED

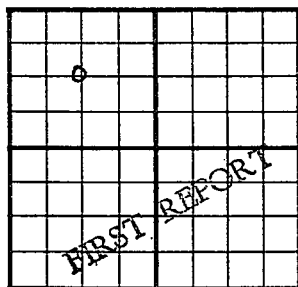
County Seward State KansasSec. 36 (Blk. Twp.) 32 (Sur. Rge.) 34W Map No.Operator Cabot CarbonWell No. 1 Farm BaughmanElev. Location C NW/41320 Ft. From N Line NW1320 Ft. From W Line Quarter1st. Report JAN 3 1951

Completion

Remarks

Spudding Date 12-16-50Drlg. Data Hugoton Pool10" @ 476 TD 2616

J. E. TYRA

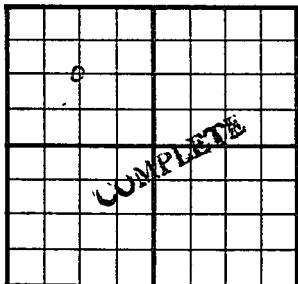County Seward State KansasSec. 36 (Blk. Twp.) 32 (Sur. Rge.) 34W Map No.Operator Cabot CarbonWell No. 1 Farm BaughmanElev. 2896 Location CNW/41320 Ft. From N Line NW1320 Ft. From W Line Quarter

1st. Report _____

Completion MAR 14 1951Remarks Hugoton PoolSpudding Date 12-16-50Drilg. Data Gas well TD 269610" @ 476 7" @ 2598 TD 2696 Her. 2600Krider 2620 Win. 2684 22000 AComp. 17,000,000 gas 397#

J. E. TYRA