


Section 28 Township 32 Range 34W

Well No. 1 Hitch "E"

Company Cities Service

Hugoton Pool

NORTH

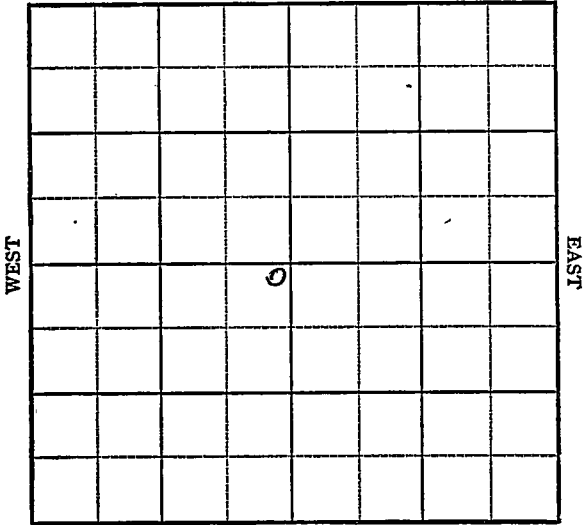

SOUTH

KANSAS

Seward

Sec. 28 Twp. 32 R. 34W ✓

Well No. #1 Hitch "E" Farm

Cities Service

Company

Hugoton Pool


100' Ft. from N. Line

_____ Ft. from S. Line

_____ Ft. from E. Line

150' Ft. from W. Line

NE SW

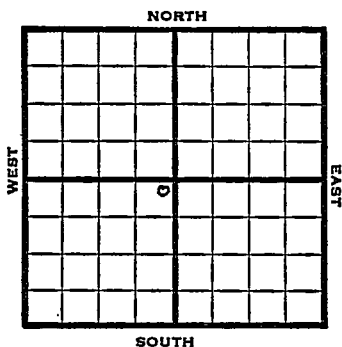

1948

Elev. 2913' REPORT

12/15 8" @ 600'
Dr1g. 1135'

12/22 TD 2713'
5" @ 2712'
120 shots 2676-2700
150 " 2628-58
60 " 2610-12
70 " 2568-82'

12/29 3500 acid
1/5 9000 acid

1/12 "

1/19 "

1/26 5" @ 2712'
Perf.
Acid 12,500
Gas 15,000,000
R. Pr. 395#
TD 2713'

COMPLETED

Map No. _____ Sec. 28 Twp. 32 R. 34W

Well No. 1 Hitch "E"

Cities Service Company

FIRST REPORT Contractor

NE SW

SECTION PLAT

100 Ft. from N. Line

_____ Ft. from S. Line

150 Ft. from E. Line

_____ Ft. from W. Line

Seward County

Location _____

Rig up _____

Drilling and Remarks:

8" @ 600

drlg. 1135

RECORD

Cased _____ in., _____ ft.

Sand _____

Gas _____

Oil _____

Total Depth _____

PRODUCTION

1st 24 hrs. Nat. _____

1st 24 hrs. after shot _____

Gas _____ Cu. Ft.

Dry Hole _____

Abandoned _____

Date

DEC 15 1948 19

S. J. LEWIS

Scout

Map No. _____ Sec. 28 Twp. 32 R. 34W

Well No. 1 Hitch "E"

Cities' Service

Company

COMPLETE

Contractor

NE SW


E. 2713
SECTION PLAT

100 Ft. from N. Line

Ft. from S. Line

150 Ft. from E. Line

Ft. from W. Line

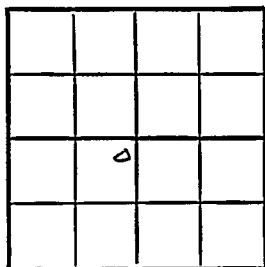

Seward County

Location

Rig up

Drilling and Remarks:

5' 2713

Perf

1200000000

15,900,000 lbs

375 R/A

RECORD

Cased _____ in., _____ ft.

Sand _____

Gas _____

Oil _____

Total Depth *2713*

PRODUCTION

1st 24 hrs. Nat. _____

1st 24 hrs. after shot _____

Gas _____ Cu. Ft.

Dry Hole _____

Abandoned _____

Date

JAN 26 1940

19

S. J. LEWIS

Scout