


Section 29 Township 32 Range 34WWell No. 1 Hitch "B"Company Cities Service

Hugoton


NORTH

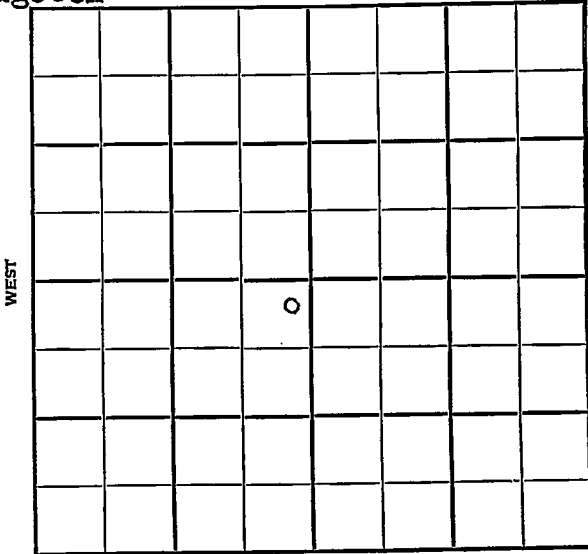

SOUTH

Sec. 29 Twp. 32 R. 34^WWell No. #1 Hitch "B" FarmCities Service Company

Hugoton

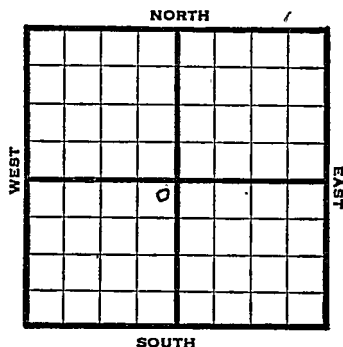100 Ft. from N. Line Ft. from S. Line100 Ft. from E. Line Ft. from W. Line

NE SW

1947

Elev. 2929' R E P O R T

10/15	Drlg. 500'		
10/22	8" @ 640		
	Drlg. 2260'		
10/29	TD 2775'		
	5" @ 2774'		
	RUST		
11/5	"		
11/12	"		
11/19	"		
11/25	"		
12/3	"		
12/10	180 shots	2694-2720	7000 acid
	160 "	2648-80	
	80 "	2616-32	
	80 "	2586-2612	
12/17	29000 acid total		
12/30	"		
1948			
1/7	"		
1/14	"		

OVER

1948

1/21

5" @ 2774'

Perf.

29,000 acid

13,200,000 gas.

426#, R. Pr.

TD 2775'

Comp.

COMPLETED

Map No. _____ Sec. 29 Twp. 32 R. 34W

Well No. 1 Hitch "B"

Cities Service

Company

FIRST REPORT

Contractor

NE SW

SECTION PLAT

100 Ft. from N. Line

_____ Ft. from S. Line

100 Ft. from E. Line

_____ Ft. from W. Line

	0		

Seward County

Location _____

Rig up _____

Drilling and Remarks:

drlg. 500

RECORD

Cased _____ in., _____ ft.

Sand _____

Gas _____

Oil _____

Total Depth _____

PRODUCTION

1st 24 hrs. Nat. _____

1st 24 hrs. after shot _____

Gas _____ Cu. Ft.

Dry Hole _____

Abandoned _____

Date

OCT 15 1947 19

S. J. LEWIS

Scout

Map No. 93 Sec. 29 Twp. 32 R. 34W

Well No. 1 Hitch "B"

Cities Service

Company

COMPLETE

Contractor

NE SW


E 1/2 2929
SECTION PLAT

100 Ft. from N. Line

 Ft. from S. Line

100 Ft. from E. Line

 Ft. from W. Line

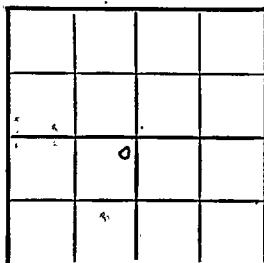

Seward County

Location

Rig up

Drilling and Remarks:

5' @ 2774

Perf.

250000 acid

10,200,000 Gas

426 # R B

RECORD

Cased in., ft.

Sand

Gas

Oil

Total Depth 2775

PRODUCTION

1st 24 hrs. Nat.

1st 24 hrs. after shot

Gas Cu. Ft.

Dry Hole

Abandoned

Date

JAN 21 1948

19

S. J. LEWIS Scout