


Seward

Map No. Kansas Sec. 33 Twp. 32 R. 34 ^W

Well No. 1 Unknown Farm
Vickers Pet Company

1320 Ft. from N. Line
 _____ Ft. from S. Line
 _____ Ft. from E. Line
1320 Ft. from W. Line

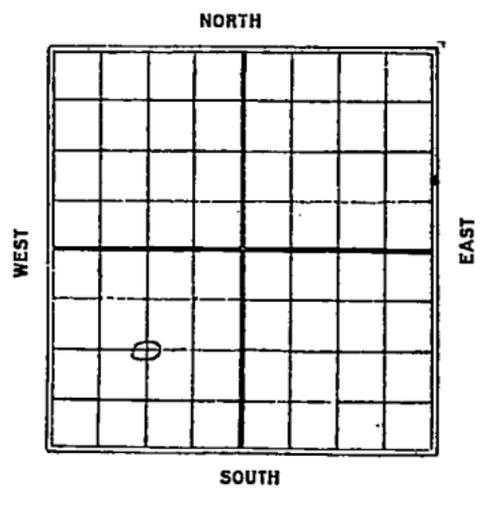

Date	REPORT
1926	
7/9	Location
9/1	P. O. P.
9/8	rig
9/15	rig
9/22	rigging up
9/29	_____
10/6	_____
10/13	Spud
10/20	Spud & S.D.
10/27	_____
11/3	S.D. to run gas line to
"	old gas well.
11/10	No report
11/17	S.D.
11/24	Same
12/1	Daly 500'
12/8	" 560'
12/15	" 750'
12/21	" 785
12/29	no report
1927	
1/12	T.D. 1200 fishing tools

- 1/19 - T.D. 1200
1/26 - Drlg - 1300
2/2 - T.D. 1300 - S.D.
2/9 - T.D. 1300 - S.D. - welding 3
joints 12" for bottom of string
2/16 - _____
2/23 - Drlg 1500
3/2 - T.D. 1695 - UR. 10"
3/9 - T.D. 1750 - UR.
3/16 - T.D. 1800 - UR. 10" @ 1734
3/23 - Drlg 1895
3/30 - T.D. 1895 - fishing pipe
4/6 - T.D. 2200 - straight ream 10"
4/13 - T.D. 2200 - fishing tools
4/20 - _____
5/4 - Showing gas 2953 to 60
Drilling 2960
5/11 - Drlg 3300
5/18 - T.D. 3450 - u.R.
5/25 - Drlg 3509
6/1 - T.D. 3509 (S.L.M.) - S.D.
6/8 - _____
6/15 - Drlg 3557
6/22 - " 3620
6/29 - " 3750
7/6 - no report
7/13 - Drlg 4000
7/20 - T.D. 4037
Abandoned

Map No. *KANSAS* Sec. *33* Twp. *32* R. *34W*

Well No. *1 Hitch*

Vickers P & Co. Company

Contractor

SECTION PLAT

1320 Ft. from N. Line

_____ Ft. from S. Line

_____ Ft. from E. Line

1320 Ft. from W. Line

	⊙		

ABANDONED

Location _____

Rig up _____

Drilling and Remarks:

TII 4037

RECORD

Cased _____ in., _____ ft.

Sand _____

Gas _____

Oil _____

Total Depth _____

PRODUCTION

1st 24 hrs. Nat. _____

1st 24 hrs. after shot _____

Gas _____ Cu. Ft.

Dry Hole _____

Abandoned _____

Date

JUL 20 1927

S. J. LEWIS

Scout

no map
Seward Co
Map No. _____ Sec. **33** Twp. **32** R. **34** *11*

Well No. **1** *Unifigore*
Vickers Ref Co Company

Contractor _____

FIRST REPORTS

SECTION PLAT

1320 Ft. from N. Line
_____ Ft. from S. Line
_____ Ft. from E. Line
1320 Ft. from W. Line
3500 *Test*

	⊙		

Location _____
Rig up _____
Drilling and Remarks: _____

RECORD

Cased _____ in., _____ ft.
Sand _____
Gas _____
Oil _____
Total Depth _____

PRODUCTION

1st 24 hrs. Nat. _____
1st 24 hrs. after shot _____
Gas _____ Cu. Ft.
Dry Hole _____
Abandoned _____

Date
JUL 9 1926
_____ 192

CHAS. L. SHERWOOD
Scout

Map No. KANSAS Sec. 33 Twp. 22 R. 24 W

Well No. 1

Vickers P. & S. Company

Contractor

SECTION PLAT

1320 Ft. from N. Line

----- Ft. from S. Line

----- Ft. from E. Line

1320 Ft. from W. Line

FIRST REPORTS

Location -----

Rig up -----

Drilling and Remarks:

*Location
3000 Test.*

RECORD

Cased ----- in., ----- ft.

Sand -----

Gas -----

Oil -----

Total Depth -----

PRODUCTION

1st 24 hrs. Nat. -----

1st 24 hrs. after shot -----

Gas ----- Cu. Ft.

Dry Hole -----

Abandoned -----

Date

JUL 14 1926

S. J. LEWIS

Scout

MAP No. _____ Sec. 33 TWP. 37S R. 34W

WELL No. 1 Hitch

Upchurch COMPANY

CONTRACTOR

no wall map

SECTION PLAT

_____ FT. FROM N. LINE

_____ FT. FROM S. LINE

_____ FT. FROM E. LINE

_____ FT. FROM W. LINE

RECORD

LOCATION _____

CASED _____ IN. _____ FT.

RIG UP _____

SAND _____

DRILLING AND REMARKS:

GAS _____

OIL _____

TOTAL DEPTH. 4015

PRODUCTION

1ST 24 HRS. NAT. _____

1ST 24 HRS. AFTER SHOT _____

GAS _____ CU. FT.

DRY HOLE

ABANDONED

DATE

7/4 1927 _____ SCOUT