

FORM 51 IOM 12-46 PETROL

Section 24 Township 32 Range 34N

Well No. _____

Company Cities Service


KANSAS

Seward county

Sec. 24 Twp. 32 R. 34W

Well No. 1 Bonley Farm

Cities Service Company


Hugoton Pool

 Ft. from N. Line

100 Ft. from S. Line

100 Ft. from E. Line

 Ft. from W. Line

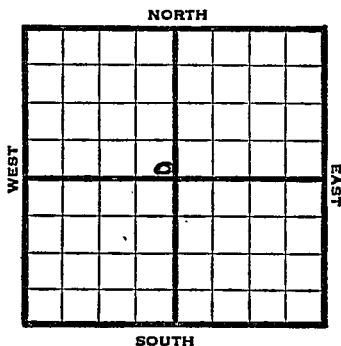

SE NW

1947 Elev. 2873' REPORT

6/25	Location
7/1	RUR
7/8	8" @ 720' Drlg. 1770'
7/16	TD 2728' 5" @ 2727'
7/22	"
7/29	"
8/6	"
8/13	"
8/20	"
8/27	"
9/3	"
9/10	"
9/17	"

OVER

1947

9/24 5" @ 2727'
Perf.
32000 Acid
13,630,000 Gas
401# R. Pr.
TD 2728'

COMPLETED

Map No. _____ Sec. 24 Twp. 32 R. 34W

Well No. 1 Bonley

Cities Service Company

FIRST REPORT Contractor

SE NW


SECTION PLAT

_____ Ft. from N. Line

100 Ft. from S. Line

100 Ft. from E. Line

_____ Ft. from W. Line

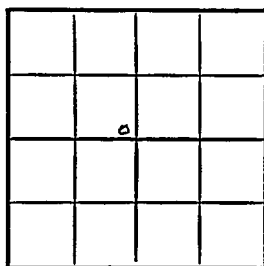

Seward County

Location _____

Rig up _____

Drilling and Remarks:

RECORD

Cased _____ in., _____ ft.

Sand _____

Gas _____

Oil _____

Total Depth _____

PRODUCTION

1st 24 hrs. Nat. _____

1st 24 hrs. after shot _____

Gas _____ Cu. Ft.

Dry Hole _____

Abandoned _____

Date

JUN 25 1947 19

S. J. LEWIS Scout

Map No. 0 Sec. 24 Twp. 32 R. 34WWell No. 1 Bonley

Cities Service

Company

COMPLETE

Contractor

SE NW

E1, 2823

SECTION PLAT

Ft. from N. Line

100 Ft. from S. Line100 Ft. from E. Line

Ft. from W. Line

Seward County

Location

Rig up

Drilling and Remarks:

8" @ 2727

Perf.


13,630,000 Gas

H.D. # R/P

RECORD

Cased _____ in., _____ ft.

Sand _____

Gas _____

Oil _____

Total Depth 2728

PRODUCTION

1st 24 hrs. Nat. _____

1st 24 hrs. after shot _____

Gas _____ Cu. Ft.

Dry Hole _____

Abandoned _____

Date

SEP 24 1947 19

S I LEWIS

Scout