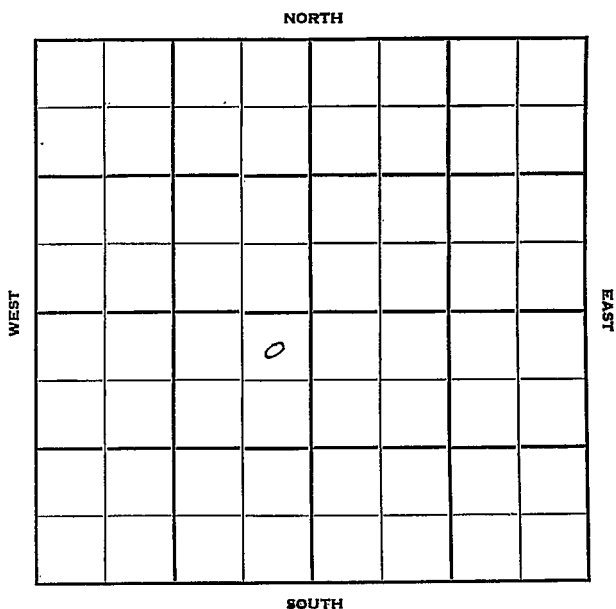


Section 25 Township 32 Range 34WWell No. #1 HitchCompany Cabot Carbon

(Blk.)
(Twp.)

Cabot Carbon

7

2852

N

I

1st. Report

DEC 13 1950

Hugoton Pool

10-26-50

Gas well

10" @ 414

Her. 2550

13000 total acid