


Section 5 Township 32 Range 34W

Well No. #1 Jerman

Company Southwestern Explor.

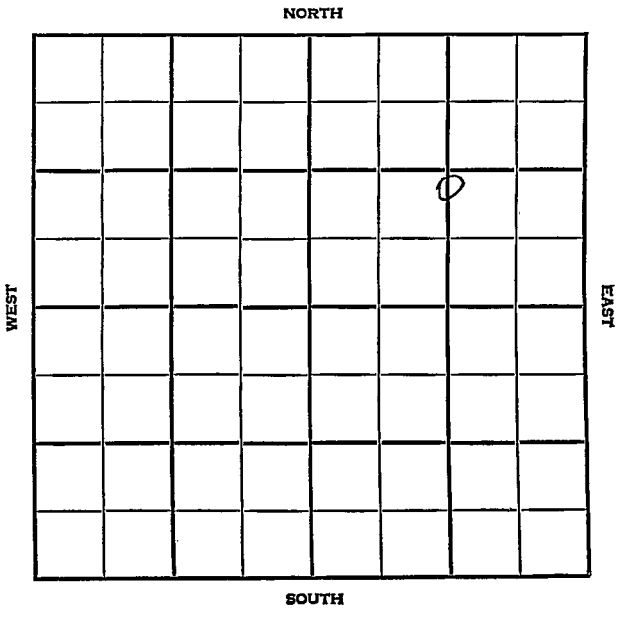

Seward KANSAS

SEC.	5	TWP.	32	R.	34W
------	---	------	----	----	-----

WELL NO.

1. Jerman

FARM

COMPANY

Southwestern Explor.

CONTRACTOR

Derby

Hugoton Pool

1420


Ft. from N. Line

Ft. from S. Line

1320

Ft. from E. Line

Ft. from W. Line

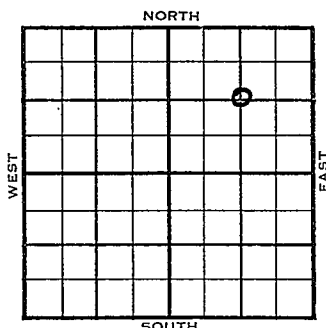

C NE/4

Nor. Nat. Farmout

1954

ELEVATION

2815'

REPORT


1/18/11

Spdg 8-8-54
 8 5/8" @ 473
 drlg. 1630

9/8

Spud 8-8-54 - Gas Well
 TD 2630'
 8-5/8" @ 473'
 Hol 2460', Her. 2503', Win 2603'
 TD 2607'
 Schl Tbps: Her. 2500', Kri 2534',
 Win. 2605'
 5" @ 2605'
 DD 2615'
 30,000 cfg
 DD 2630'
 A-frac, 4,250,000 cfg, SP 2590
 62/2501-14, 20/2537-42, 124/2558-89,
 4 1/2 mcfg dol-frac 12,000,000 cfg
 Comp. opn flow 13,500,000 cfgpd
 450#

COMPLETED

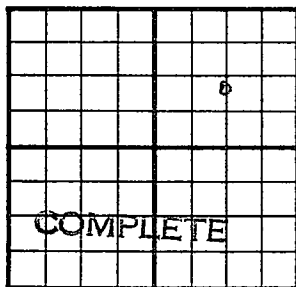County Seward State KansasSec. 5 (Blk.
Twp.) 32 (Sur.
Rge.) 34W Map No.Operator Southwestern Explor.Well No. 1 Farm JermaElev. 2815 Location C NE/41420 Ft. From N Line NE1320 Ft. From E Line Quarter

1st. Report

Completion SEP 8 1954Remarks Hugoton PoolDerby - Contr.Spudding Date 8-8-54Drlg. Data Gas well TD 26308 5/8" @ 473 Hol. 2460 Her. 2503Win. 2603 TD 2607 SCHLUMBERGER TOPSHer. 2500 Kri. 2534 Win. 26055" @ 2605 DD 2615 30,000 cfg DD 2630A-frac 4,250,000 cfg SP 2590 62/ 2501-14 20/ 2537-42 124/ 2558-89 4 1/2 mcfgdol-frac 12,000,000 cfgComp. open flow 13,500,000 cfgpd 450#

FABEN GILSTRAP

