

# KANSAS

Seward

Section 9 Township 32 Range 34W

Well No. 1 Downing

Company Cities Service

Hugoton  
NORTH

				0			

WEST

EAST

SOUTH

Sec. 9 Twp. 32 R. 34W

Well No. #1 Downing Farm

Cities Service

(Corbitt & Barber, Cont.) Company

Hugoton  
Pool

NORTH


100' Ft. from N. Line

\_\_\_\_\_ Ft. from S. Line

\_\_\_\_\_ Ft. from E. Line

100' Ft. from W. Line

NW SE

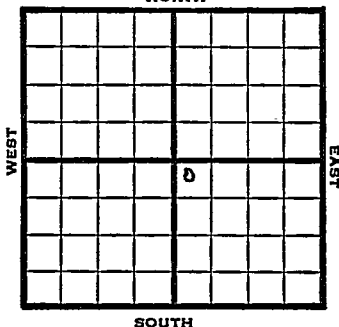

SOUTH

1949

Elev 2890'

REPORT

6/22	Location
6/28	"
7/6	"
7/12	"
7/20	8" @ 520'
7/27	TD 2820'
	5" @ 2819'
8/3	TD 2830'
8/10	260 shots 2670-2762 - 3000 acid WPB
8/17	"
8/24	"
8/31	"
9/7	"
9/14	"
9/21	"
9/28	"
10/5	"
10/12	"
10/19	7000 acid
10/26	"
11/1	"
11/9	"
11/16	"
11/23	"
11/29	"
12/7	"

COVER

1949

12/14 7000 acid  
12/21 " "  
12/28 " "

1950

1/11 TD 2830'  
8"@ 520'  
5"@ 2819'  
Hev 2628'  
Kr 2701'  
Win 2726'  
Perf 10/2770-72'  
Perf 180-2726-62  
Perf 40/2702-10  
Perf 40/2670-78'  
50,0000 acid  
Plug back to 275'  
D&A  
Aband.

**ABANDONED**

Kansas

Map No. \_\_\_\_\_ Sec. 9 Twp. 32 R. 34W

Well No. 1 Downing

Cities Service Company

Corbitt &amp; Barber Contractor

NW Se 1

FIRST REPORT  
SECTION PLAT

100 Ft. from N. Line

\_\_\_\_\_ Ft. from S. Line

\_\_\_\_\_ Ft. from E. Line

100 Ft. from W. Line

		o	

Seward County

Location X

Rig up \_\_\_\_\_

Drilling and Remarks:

## RECORD

Cased \_\_\_\_\_ in., \_\_\_\_\_ ft.

Sand \_\_\_\_\_

Gas \_\_\_\_\_

Oil \_\_\_\_\_

Total Depth \_\_\_\_\_

## PRODUCTION

1st 24 hrs. Nat. \_\_\_\_\_

1st 24 hrs. after shot \_\_\_\_\_

Gas \_\_\_\_\_ Cu. Ft.

Dry Hole \_\_\_\_\_

Abandoned \_\_\_\_\_

Date

JUN 22 1949 19

S. J. LEWIS Scout

~~31933~~

Map No. \_\_\_\_\_ Sec. 9 Twp. 32 R. 34W

Well No. 1 Downing

Cities Service Company

Contractor

NW SE

*Elv. 2890*  
SECTION PLAT

100 Ft. from N. Line

\_\_\_\_\_ Ft. from S. Line

\_\_\_\_\_ Ft. from E. Line

100 Ft. from W. Line

ABANDONED			
		o	

Seward County

Location \_\_\_\_\_

Rig up \_\_\_\_\_

Drilling and Remarks:

*8" @ 520*  
*5" @ 2819*  
*Kr 2628*  
*Kr 2701*  
*Win 2726*

RECORD

Cased \_\_\_\_\_ in., \_\_\_\_\_ ft.

Sand \_\_\_\_\_

Gas \_\_\_\_\_

Oil \_\_\_\_\_

Total Depth 2830

PRODUCTION

1st 24 hrs. Nat. \_\_\_\_\_

1st 24 hrs. after shot \_\_\_\_\_

Gas \_\_\_\_\_ Cu. Ft.

Dry Hole \_\_\_\_\_

Abandoned \_\_\_\_\_

Date

*(over)*

JAN 11 1950

19

J. E. TYRA

Scout

Per 5-20/2770-72

180/2726-62

40/2702-10

40/2670-78

5,000 acid

Plug back to 275'

D.V.A.

JAN 16 1950

Scout Cards	<i>Edith</i>
Land Small Map	.....
Land Wall Map	.....
Tracings	.....
France Map	.....
Pierce Map	.....
Misc.	.....

Kansas

Hugoton Pool

Map No. \_\_\_\_\_ Sec. 9 Twp. 32 R. 34W

Well No. 1 Downing

Cities Service Company

Contractor

NW SE

*E. 2890*

SECTION PLAT

100 Ft. from N. Line

\_\_\_\_\_ Ft. from S. Line

\_\_\_\_\_ Ft. from E. Line

100 Ft. from W. Line

		0	

*Correct Measurement*

Seward County

Location \_\_\_\_\_

Rig up \_\_\_\_\_

Drilling and Remarks:

*8" @ 520*

*5" @ 2819*

*Per. 2628*

*Rider 2701*

*Win. 2726*

*10000 acid*

*Q + A*

RECORD

Cased \_\_\_\_\_ in., \_\_\_\_\_ ft.

Sand \_\_\_\_\_

Gas \_\_\_\_\_

Oil \_\_\_\_\_

Total Depth 2830

PRODUCTION

1st 24 hrs. Nat. \_\_\_\_\_

1st 24 hrs. after shot \_\_\_\_\_

Gas \_\_\_\_\_ Cu. Ft.

Dry Hole \_\_\_\_\_

Abandoned \_\_\_\_\_

Date

JAN 11 1950 19

J. E. TYRA Scout