


Sec. 16 Twp. 32 R. 34W

Well No. #1 Kapp Farm _____

Cities Service Company
Hugoton

100 Ft. from N. Line
____ Ft. from S. Line
____ Ft. from E. Line
100 Ft. from W. Line
NW SE

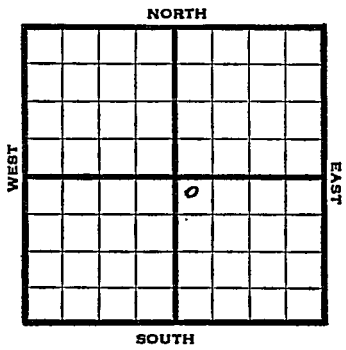

REPORT

1947	Elev. 2929'
4/2	Location.
4/9	"
4/15	"
4/23	"
4/29	8" @ 805 WOC
5/7	TD 2841' 5" @ 2802' RUST
5/13	"
5/20	"
5/27	"
6/3	50 shots 2586-96 120 shots 2612-28 150 shots 2642-72-3500 acid
6/10	" "

OVER

6/17 7500' Acid.

6/24 " "

7/2 5" @ 2802'
Perf.
32500 Acid
17W
403# R. Pr.
TD 2841'

COMPLETED

Map No. _____ Sec. 16 Twp. 32 R. 34W

Well No. 1 Kapp

Cities Service Company

FIRST REPORT

Contractor

NW SE

SECTION PLAT

100 Ft. from N. Line

_____ Ft. from S. Line

_____ Ft. from E. Line

100 Ft. from W. Line

		o	

Seward County

Location X

Rig up _____

Drilling and Remarks:

RECORD

Cased _____ in., _____ ft.

Sand _____

Gas _____

Oil _____

Total Depth _____

PRODUCTION

1st 24 hrs. Nat. _____

1st 24 hrs. after shot _____

Gas _____ Cu. Ft.

Dry Hole _____

Abandoned _____

Date

APR 2 1947 19

S. J. LEWIS Scout

