


Section 19 Township 32 Range 34-W
 Well No. #1 Marteney "B"
 Company Cities Service

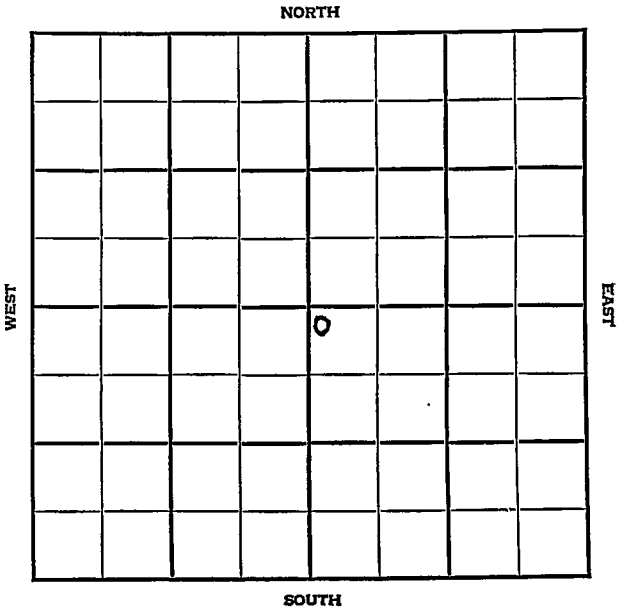

KANSAS
Sec. 19 Twp. 32 R. 34W
Well No. #1 Marteney "B" Farm
Cities Service Company

Hugoton Pool


100' Ft. from N. Line

 Ft. from S. Line

 Ft. from E. Line

100' Ft. from W. Line

NW SE

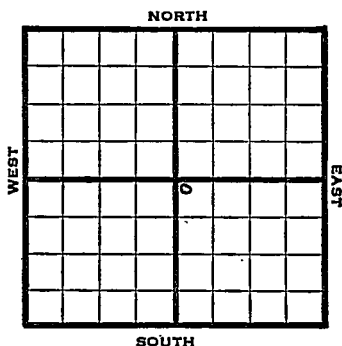

1948	El 2966'	REPORT
5/5	Location	
5/12	8" @ 640'	
	Drlg. 1080'	
5/19	TD 2800	
	3" @ 2799'	
5/26	90 shots 2722-40' - 4500 acid	
	60 shots 2608-20'	
	50 shots 2640-50'	
	160 shots 2670-2702'	
6/1	2500 acid.	
6/9	20,000 Acid	
6/16	"	
6/23	TD 2800'	
	5"@ 2799'	
	Perf 18000 acid	
	14 M Gas	
	396# R pr.	
	Comp.	
	COMPLETED	

Map No. _____ Sec. 19 Twp. 32 R. 34W

Well No. 1 Marteney "B"

Cities Service Company

FIRST REPORT

Contractor

NW SE

SECTION PLAT

100 Ft. from N. Line

_____ Ft. from S. Line

_____ Ft. from E. Line

100 Ft. from W. Line

		o	

Seward County

Location X

Rig up _____

Drilling and Remarks:

RECORD

Cased _____ in., _____ ft.

Sand _____

Gas _____

Oil _____

Total Depth _____

PRODUCTION

1st 24 hrs. Nat. _____

1st 24 hrs. after shot _____

Gas _____ Cu. Ft.

Dry Hole _____

Abandoned _____

Date

MAY 5 1948 19 S. J. LEWIS Scout

Map No. _____ Sec. 19 Twp. 32 R. 34W

Well No. 1 Marteney "B"

_____ Cities Service _____ Company

COMPLETE

_____ Contractor

NW SE

E 12966
SECTION PLAT

100 Ft. from N. Line

_____ Ft. from S. Line

_____ Ft. from E. Line

100 Ft. from W. Line

		6	

Seward County

Location _____

Rig up _____

Drilling and Remarks:

5" C2788

Prof.

1900 sand

14 M. Gas.

396 # R. B.

RECORD

Cased _____ in., _____ ft.

Sand _____

Gas _____

Oil _____

Total Depth 2800

PRODUCTION

1st 24 hrs. Nat. _____

1st 24 hrs. after shot _____

Gas _____ Cu. Ft.

Dry Hole _____

Abandoned _____

5

Date

JUN 23 1948 19 _____ S. J. LEWIS Scout