


Section 9 Township 32 Range 34W

Well No. #2 Downing

Company Cities Service
Hugoton Pool

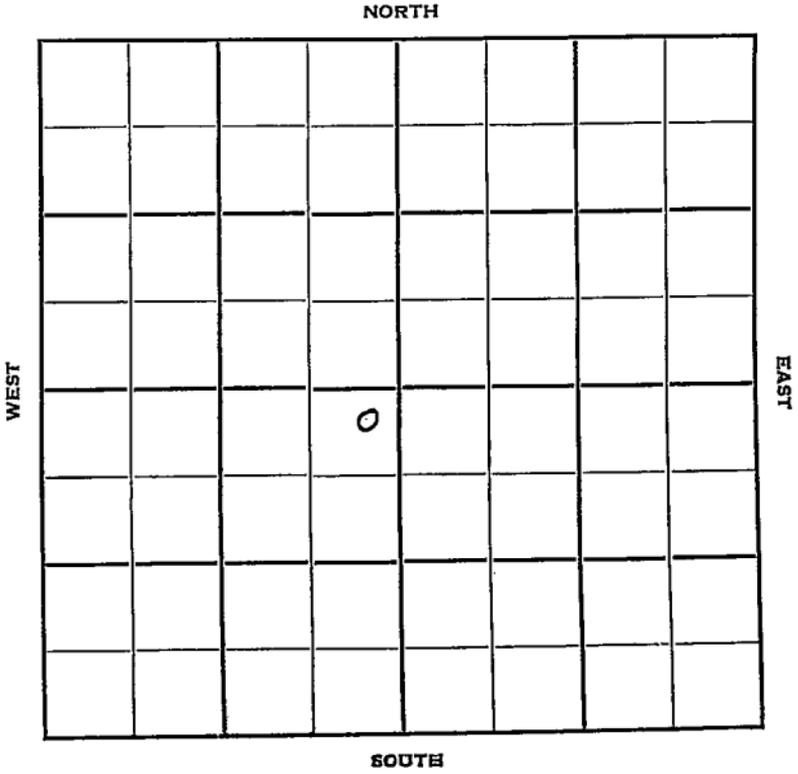

Sec. 9 Twp. 32 R. 34W

Well No. #2 Downing Farm

Cities Service

Company

Hugoton Pool (Corbett & Barber, Contr.)


NORTH

~~100~~ ¹²⁵⁰ Ft. from N. Line

~~250~~ ²⁵⁰ Ft. from S. Line

~~250~~ ¹²⁵⁰ Ft. from E. Line

~~100~~ ¹⁰⁰ Ft. from W. Line

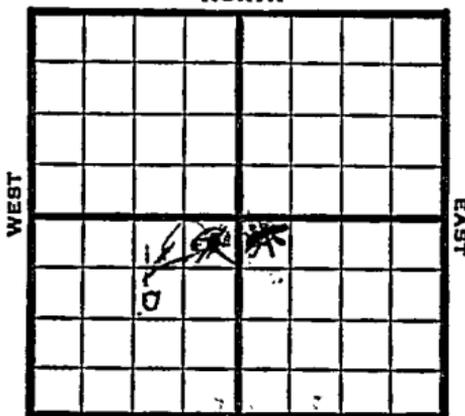

~~NE SW~~ ~~NE SE~~ ~~SW NE~~ ~~SW~~

1949 Elev ~~2890~~ ²⁹²⁹ REPORT

12/21
12/21
12/28
1950
1/11

Location

"

"

~~TD 2830'~~
~~8" @ 520'~~
~~5" @ 2819'~~
~~Henry 2628'~~
~~Krider 2701'~~
~~Win 2726'~~
~~1000 acid~~
~~P&A~~
~~Aband.~~

2/1 TD 2740'
 8" @ 640'
 5" @ 2739'
 Hev 2996'
 L Cr 2656'
 Win 2704'
 16,300,000 CFGPD
 Comp

ABANDONED

Correction ticket sent in on this. Edith

Map No. _____ Sec. 9 Twp. 32 R. 34W

Well No. 2 Downing

Cities Service Company

Corbett & Barber Contractor

NE SW

**FIRST REPORT
SECTION PLAT**

_____ Ft. from N. Line

250 Ft. from S. Line

250 Ft. from E. Line

_____ Ft. from W. Line

		o	

Seward County

Location X

Rig up _____

Drilling and Remarks: _____

RECORD

Cased _____ in., _____ ft.

Sand _____

Gas _____

Oil _____

Total Depth _____

PRODUCTION

1st 24 hrs. Nat. _____

1st 24 hrs. after shot _____

Gas _____ Cu. Ft.

Dry Hole _____

Abandoned _____

Date

DEC 21 1949 19

S. J. LEWIS Scout

DEC 23 1949

Scout Cards
Land Small Map
Land Wall Map
Tracings
F. m. e. p
.....
.....

Map No. _____ Sec. 9 Twp. 32 R. 34W

Well No. 2 Downing

Cities Service Company

Contractor

SW NE SW

E. 2929
SECTION PLAT

1250 Ft. from N. Line

COMPLETE			
	↙		

_____ Ft. from S. Line

1250 Ft. from E. Line

_____ Ft. from W. Line

Seward County

Location _____

RECORD

Rig up _____

Cased _____ in., _____ ft.

Drilling and Remarks:

Sand _____

Gas _____

Oil _____

Total Depth 2740

8" @ 640

5" @ 2739

Rev. 2996

LCr. 2656

win 2704

PRODUCTION

1st 24 hrs. Nat. _____

1st 24 hrs. after shot _____

Gas _____ Cu. Ft.

Dry Hole _____

Abandoned _____

16,300,000

CFGPD

Date

FEB 1 1950 19

J. E. TYRA Scout

1st Report shows

no - no Alt

check ft measurements
+ report

advised
Sam

This is right. First Report incorrect.

FEB 9 1950

Scout Cards	Edith
Land Small Map	
Land Wall Map	3
Tracings	
France Map	
Bierce Map	
Misc.	