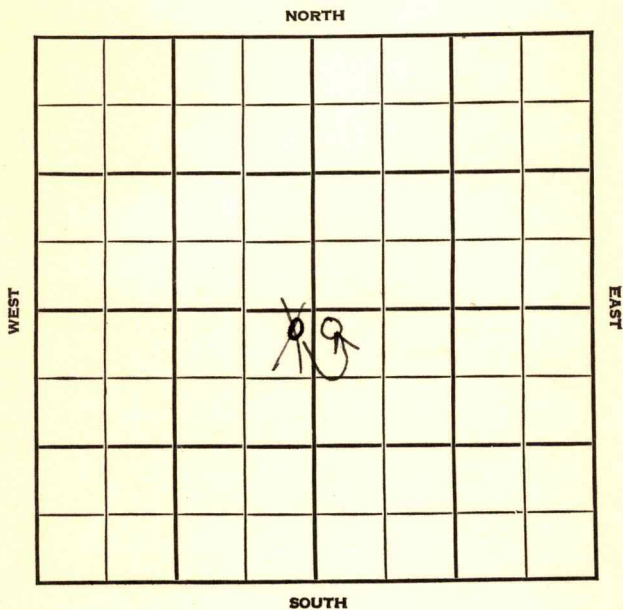


Section 10 Township 32 Range 34-WWell No. #1 HickmanCompany Cities Service

Sec. 10 Twp. 32 R. 34W

Well No. #1 Hickman Farm

Cities Service

Company

Hugoton Pool

100' Ft. from N. Line


Ft. from S. Line

100' Ft. from E. Line

100' Ft. from W. Line

NE SW

~~NW SW~~ NW SE

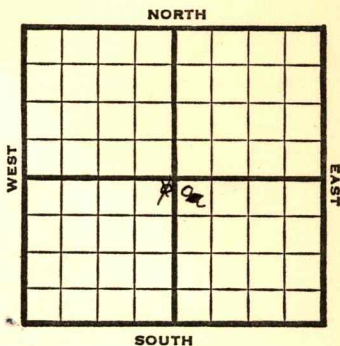

1948

Eli 2913'

REPORT

5/5 Location

5/12 "

5/19 "

5/26 "

6/1 "

6/9 8" @ 600'
5" @ 2799'
TD 2800'

6/16 "

6/23 "

6/29 130 sjots 2734-60 -6500 acid
160 shots 2688-2720
50 shots 2630-40 2000 acid

7/8 " "

7/14 " "

8/21 TD 2800'
5" @ 2799'
Perf 8500 acid
7,730,000 Gas
408# RPR.
Comp.

COMPLETED

Hugoton Pool

Map No. _____ Sec. 10 Twp. 32 R. 34W

Well No. 1 Hickman

Cities Service Company

COMPLETE

Contractor

NW SE

E. 2913

SECTION PLAT

100 Ft. from N. Line

_____ Ft. from S. Line

_____ Ft. from E. Line

100 Ft. from W. Line

		0	

Seward County

Location _____

Rig up _____

Drilling and Remarks:

5-102799

Perf
8500 acs C

7,730,000 Gas

408422

RECORD

Cased _____ in., _____ ft.

Sand _____

Gas _____

Oil _____

Total Depth 2880

PRODUCTION

1st 24 hrs. Nat. _____

1st 24 hrs. after shot _____

Gas _____ Cu. Ft.

Dry Hole _____

Abandoned _____

Date

JUL 21 1948

19

S. J. LEWIS

Scout

Map No. _____ Sec. 10 Twp. 32 R. 34W

Well No. 1 Hickman

Cities Service Company

FIRST REPORT Contractor

NE SW

SECTION PLAT

100 Ft. from N. Line

_____ Ft. from S. Line

100 Ft. from E. Line

_____ Ft. from W. Line

	o		

Seward County

Location X

Rig up _____

Drilling and Remarks:

RECORD

Cased _____ in., _____ ft.

Sand _____

Gas _____

Oil _____

Total Depth _____

PRODUCTION

1st 24 hrs. Nat. _____

1st 24 hrs. after shot _____

Gas _____ Cu. Ft.

Dry Hole _____

Abandoned _____

Date

MAY 5 1948 19 _____ S. J. LEWIS Scout

Map No. _____ Sec. 10 Twp. 32 R. 34W

Well No. 1 Hickman

Cities Service

Company

CORRECTION

Contractor

NW

SE

?

SECTION PLAT

		o	

100 Ft. from N. Line

_____ Ft. from S. Line

_____ Ft. from E. Line

100 Ft. from W. Line

Seward County

Location _____

Rig up _____

Drilling and Remarks:

Reported

NE SW

RECORD

Cased _____ in., _____ ft.

Sand _____

Gas _____

Oil _____

Total Depth _____

PRODUCTION

1st 24 hrs. Nat. _____

1st 24 hrs. after shot _____

Gas _____ Cu. Ft.

Dry Hole _____

Abandoned _____


Date

MAY 26 1948 19__

S. J. LEWIS

Scout

check spot

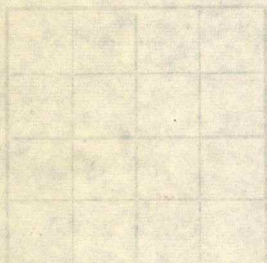

100. Ft. from N. line
100. Ft. from S. line
100. Ft. from E. line
100. Ft. from W. line

Misc. Small Maps	
Cards	<i>Both</i>
Tracing	
France Map	<i>2</i>
Scarborough Map	<i>2</i>
Pierce Map	<i>1</i>
Geological Dept.	
Pierce Plot Book	

MAY 2 1948

Map No. _____ Sec. 10 Twp. 32 R. 34W

Well No. 1 Hickman

Cities Service

Company

CORRECTION

Contractor

NW SE


SECTION PLAT

100 Ft. from N. Line

_____ Ft. from S. Line

_____ Ft. from E. Line

100 Ft. from W. Line

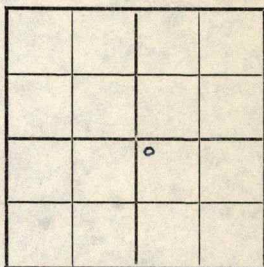

Seward County

Location _____

Rig up _____

Drilling and Remarks:

Reported
NW SW

RECORD

Cased _____ in., _____ ft.

Sand _____

Gas _____

Oil _____

Total Depth _____

PRODUCTION

1st 24 hrs. Nat. _____

1st 24 hrs. after shot _____

Gas _____ Cu. Ft.

Dry Hole _____

Abandoned _____

Date

JUN 1 1948 19 S. J. LEWIS Scout


check range

Should this be

Morton Co - 40 W

or

Seward Co. - 34 W

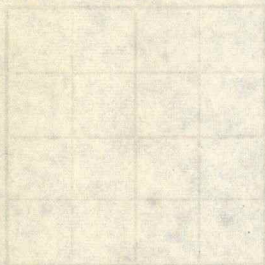

RECORD

Misc. Small Maps

Cards *Luth*

Tracing *✓*

France Map *✓*

Scarborough Map *✓*

Pierce Map *✓*

Geological Dept. *✓*

Pierce Plat Book *✓*