

Seward


FORM 51 10M 12-46 PETROL

KANSAS

Section 12 Township 32 Range 34W

Well No. 1 Hoffman "E"

Company Cities Service

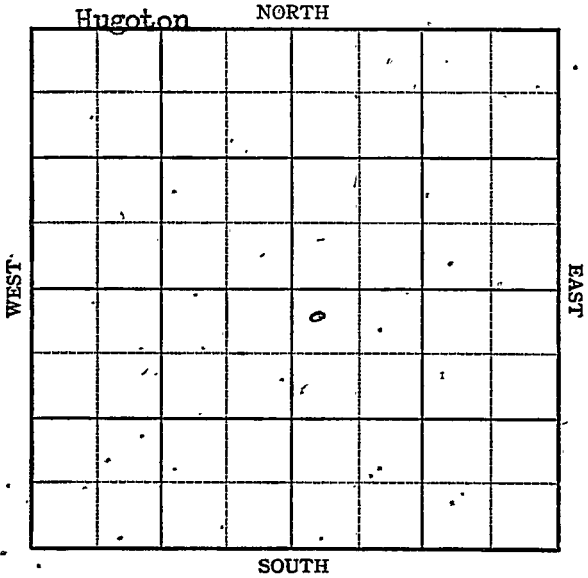

Seward

KANSAS✓

Sec. 12 Twp. 32 R. 34W

Well No. #1 Hoffman "E" Farm

Cities Service

Company


Hugoton

200 Ft. from N. Line

Ft. from S. Line

Ft. from E. Line

100 Ft. from W. Line

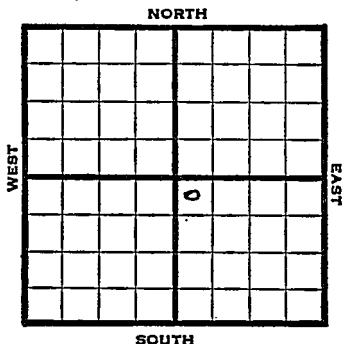

NW SE

1947

Elev. 2778' REPORT

4/2 Location.

4/9 "

4/15 8" @ 600'
Drlg. 715'

4/23 TD 2730'
Run csg.

4/29 5" @ 2729'
RUST

5/7 "

5/13 "

5/20 96 shots 2610-28
500 acid water
squeeze

5/27 " 1/2 "

6/3 5000 acid

6/10 "

6/17 "

6/24 "

OVER

7/2 5" @ 2729'
Perf.
27000 Acid
15,900,000 Gasl
401# R. Pr.
TD 2730'

COMPLETED

Map No. _____ Sec. 12 Twp. 32 R. 34W

Well No. 1 Hoffman "E"

Cities Service Company

~~IRST~~ REPORT

Contractor

NW SE

200 Ft. from N. Line

_____ Ft. from S. Line

_____ Ft. from E. Line

100 Ft. from W. Line

SECTION PLAT

		o	

Seward County

Location X

Rig up _____

Drilling and Remarks:

RECORD

Cased _____ in., _____ ft.

Sand _____

Gas _____

Oil _____

Total Depth _____

PRODUCTION

1st 24 hrs. Nat. _____

1st 24 hrs. after shot _____

Gas _____ Cu. Ft.

Dry Hole _____

Abandoned _____

Date

APR 2 1947 19

S. J. LEWIS Scout

Map No. 0 Sec. 12 Twp. 32 R. 34W

Well No. 1 Hoffman "E"

Cities Service Company

COMPLETE

Contractor

NW SE

E 1.2778
SECTION PLAT

200 Ft. from N. Line

 Ft. from S. Line

 Ft. from E. Line

100 Ft. from W. Line

		0	

Seward County

Location

Rig up

Drilling and Remarks:

5" C2729

Perf.

27000 acid

15,700,000 gal

401 # R/E

RECORD

Cased in., ft.

Sand

Gas

Oil

Total Depth 2730

PRODUCTION

1st 24 hrs. Nat.

1st 24 hrs. after shot

Gas Cu. Ft.

Dry Hole

Abandoned

Date

JUL 2 1947 19

S. J. LEWIS Scout