
FORM 51 25M 3-49 PETROL

Stevens KANSAS

Section 5 Township 32 Range 35W

Well No. #1 Keating

Company Northern Natural Gas

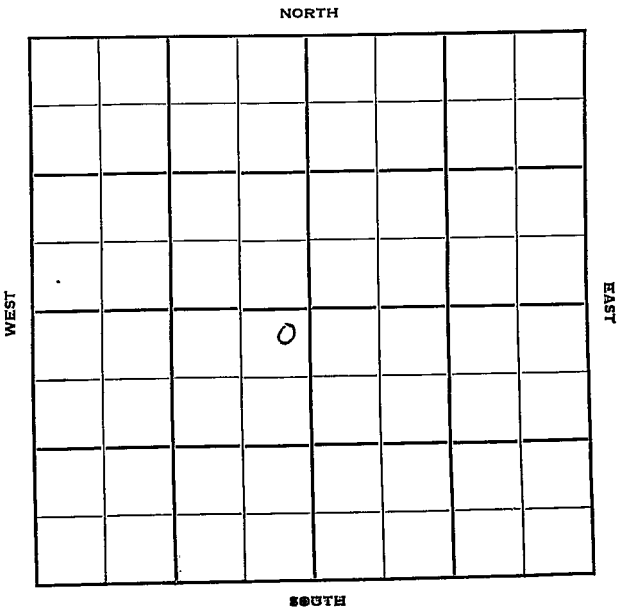

FORM 252-B
10M 9-49 PETROL

Stevens KANSAS ✓

Sec. 5 Twp. 32 R. 35W

Well No. #1 Keating Farm

Northern Natural Gas Company

Contractor

Hugoton Pool


200' Ft. from N. Line

Ft. from S. Line

200' Ft. from E. Line

Ft. from W. Line

NE SW

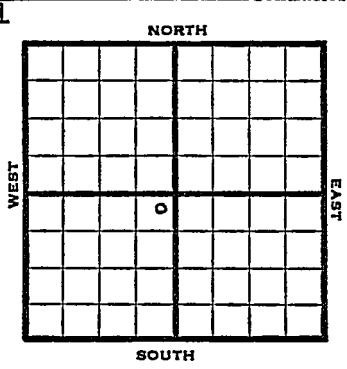

1950	Elv 3020 REPORT
5/3	Spud 5-1-50 10" @ 537' WOC
6/7	TD 2580 10" @ 537 7" @ 2570 TD 2580 open flow 24,687,000 Completed

COMPLETED

Form 26 200 Bks. 11-49 Petrol

Kansas Hugoton Pool

Map No. _____ Sec. 5 Twp. 32 R. 35W

Well No. 1 Keating

Northern Natural Gas Company

_____ Contractor

NE SW

200 Ft. from N. Line

_____ Ft. from S. Line

200 Ft. from E. Line

_____ Ft. from W. Line

SECTION PLAT



Stevens County

Location _____

Rig up _____

Drilling and Remarks:

Spud 5-1-50

10" @ 537 WOC

RECORD

Cased _____ in., _____ ft.

Sand _____

Gas _____

Oil _____

Total Depth _____

PRODUCTION

1st 24 hrs. Nat. _____

1st 24 hrs. after shot _____

Gas _____ Cu. Ft.

Dry Hole _____

Abandoned _____

Date

MAY 3 1950 19 J. E. TYRA Scout

Form 26 200 Bks. 11-49 Petrol

Hugoton Pool

Kansas

Map No. _____ Sec. 5 Twp. 32 R. 35W

Well No. 1 Keating


Northern Natural Company

Contractor

NE SW

El. 3020

SECTION PLAT

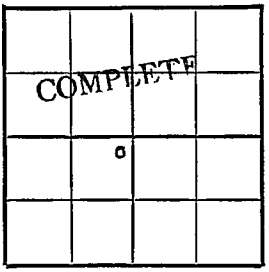

200 Ft. from N. Line

Ft. from S. Line

200 Ft. from E. Line

Ft. from W. Line

Stevens

Location

Rig up

Drilling and Remarks:

10" @ 537

7" @ 2570

T.D. 2580

Open flow

24,687,000

RECORD

Cased _____ in., _____ ft.

Sand

Gas

Oil

Total Depth 2580

PRODUCTION

1st 24 hrs. Nat.

1st 24 hrs. after shot

Gas _____ Cu. Ft.

Dry Hole

Abandoned

Date

JUN 7 1950 19

J. E. TYRA Scout