


KANSAS

FORM 51 25M 3-49 PETROL

Section 7 Township 32 Range ~~25~~ ³⁵ W
 Well No. 2 Keating
 Company Northern Natural

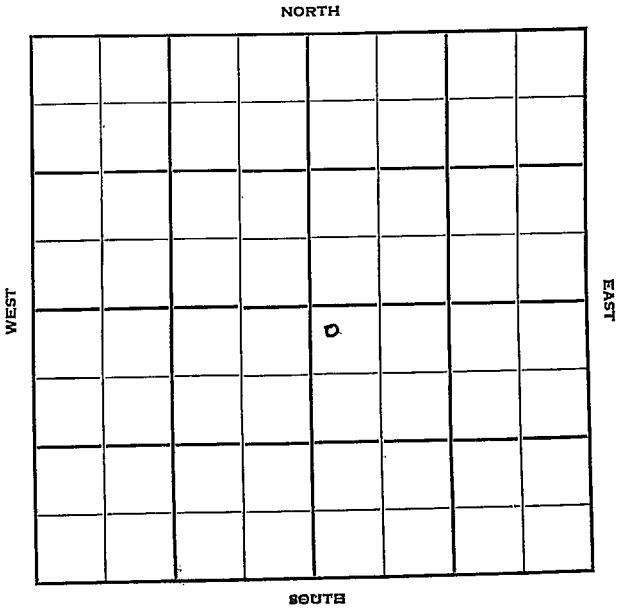



Sec. 7 Twp. 32 R. 35W

Well No. #2 Keating Farm

Northern Natural Company

Contractor

Hugoton


200 Ft. from N. Line

Ft. from S. Line

Ft. from E. Line

200 Ft. from W. Line

NW SE

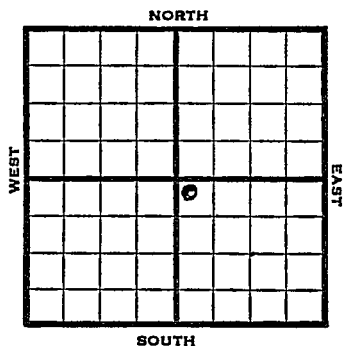

1950

Elev 3023

REPORT

5/10

Spud 5-7-50

10" O 571

W. O. C.

6/7

TD 2792

10" @ 571

7" @ 2563

258' of 5" liner

25,241,000 CFGPD

Hev 2604

Kr 2625

Win 2715-56

Ft R 2788

Completed

COMPLETED

Kansas

Hugoton

Map No. _____ Sec. 7 Twp. 32 R. 35WWell No. 2 KeatingNorthern Natural Company

Contractor


N^W SE

SECTION PLAT

200 Ft. from N. Line

_____ Ft. from S. Line

_____ Ft. from E. Line

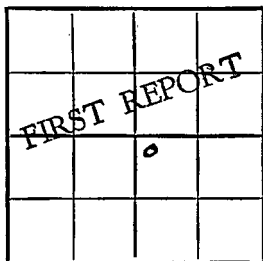200 Ft. from W. LineStevens

Location _____

Rig up _____

Drilling and Remarks:

Spud 5-7-50

10" O 571

W. O. C.

RECORD

Cased _____ in., _____ ft.

Sand _____

Gas _____

Oil _____

Total Depth _____

PRODUCTION

1st 24 hrs. Nat. _____

1st 24 hrs. after shot _____

Gas _____ Cu. Ft.

Dry Hole _____

Abandoned _____

Date

MAY 10 1950

19


J. E. TYRA Scout

Kansas Hugoton

Map No. _____ Sec. 7 Twp. 32 R. 35WWell No. 2 KeatingNorthern Natural Company_____
N¹ SE ContractorE1.3023
SECTION PLAT200 Ft. from N. Line

____ Ft. from S. Line

____ Ft. from E. Line

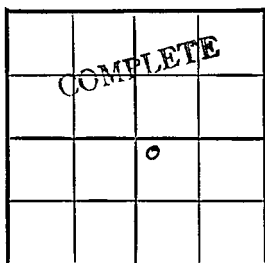200 Ft. from W. Line

Stevens

Location _____

Rig up _____

Drilling and Remarks:

10" @ 571
 7" @ 2563
 258" g 5" line
 25,241,000'
 C.F.G.P.D

RECORD

Cased _____ in., _____ ft.

Sand _____

Gas _____

Oil _____

Total Depth ~~2570~~ 2792

PRODUCTION

1st 24 hrs. Nat. _____

1st 24 hrs. after shot _____

Gas _____ Cu. Ft.

Dry Hole _____

Abandoned _____

Date

OVER

JUN 7 1950

19

J. E. TYRA Scout

Her 2604
Kr 2625
Win 2715-56
HR 2788

Scout Cards	FW
Land Small Map	
Land Wall Map	3
Tracings	
France Map	
Pierce Map	
Misc.	

JUN 15 1950