DX 78-1

Stevens KANSAS

Section 11 Township 32 Range 35W

Well No. 1 Wulfemeyer "A"

Company Northern Natural

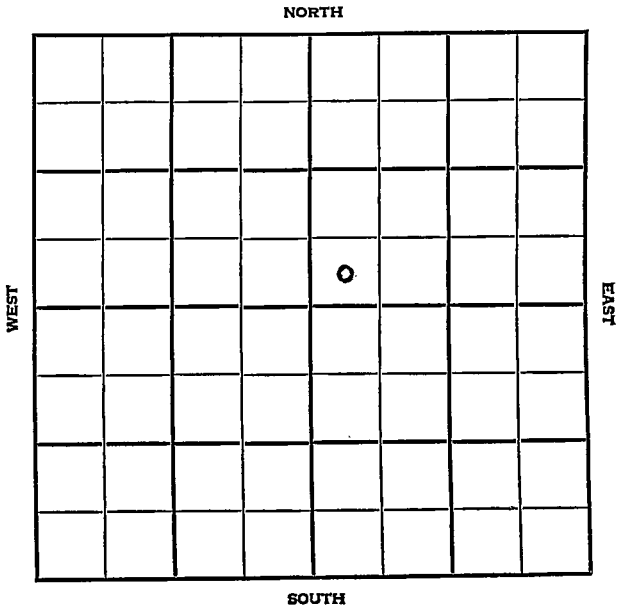

Stevens KANSAS

SEC.	TWP.	R.
11	32	35W

WELL NO.

1 Wulfemeyer "A" FARM

COMPANY

Northern Natural

CONTRACTOR

Moran

Hugoton Pool

_____ Ft. from N. Line

330 Ft. from S. Line

_____ Ft. from E. Line

330 Ft. from W. Line

SW SW NE

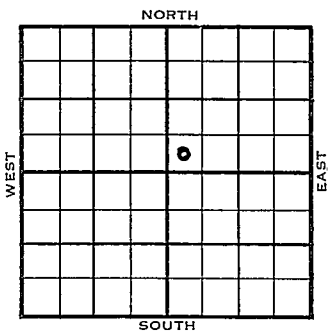

	ELEVATION	REPORT
1954	2975'	
9/8	Spud 9-3-54 10" @ 548' Drlg.1205'	
12/10	Spud 9-3-54 Gas well TD 2774 10" @ 548 er. 2600 TD 2610 7" @ 2604 DD 2705 7500 A dolo- frac. 7500 A 3,233,000 CFG DD 2771 4000 A Log tops: Herr. 2596 Kir. 2662 Win. 2704 Ft. Riley 2755 Comp. 13,163,000 CFGPD 373# COMPLETED	

FORM 275 FOR SALE BY KANSAS BLUE PRINT CO.

County Stevens State Kansas

Sec. 11 (Blk. Twp.) 32 (Sur. Rge.) 35W Map No.

Operator Northern Natural

Well No. 1 Farm Wulfemeyer "A"

Elev. 2975 Location SW SW NE

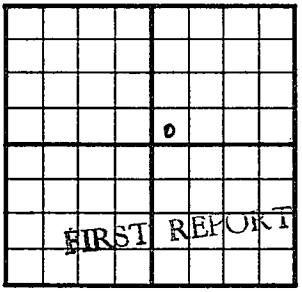

330 Ft. From S Line NE

330 Ft. From W Line Quarter

1st. Report SEP 8 1954

Completion

Remarks Moran - Contr.

Spudding Date 9-3-54

Drlg. Data Hugoton Pool

10" @ 548 drlg. 1205

FABEN GILSTRAP

FORM 275 FOR SALE BY KANSAS BLUE PRINT CO.

County Stevens State Kansas

Sec. 11 (Blk. Twp.) 32 (Sur. Rge.) 35W Map No.

Operator Northern Natural

Well No. 1 Farm Wulfemeyer "A"

Elev. 2975 Location SW SW NE

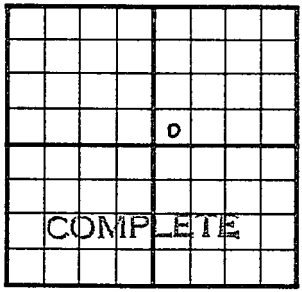

330 Ft. From S Line NE

330 Ft. From W Line Quarter

1st. Report

Completion DEC 8 1954

Remarks Hugoton Pool

Moran - Contr.

Spudding Date 9-3-54

Drlg. Data Gas well TD 2774

10" @ 548 Her. 2600 TD 2610 7" @ 2604

DD 2705 7500 A dolo-frac 7500 A

3,233,000 cfg DD 2774 4000 A

LOG TOPS:

Her. 2596 Kir. 2662 Win. 2704

Ft. Riley 2755 Comp. 13,163,000 cfgpd 373

FABEN GILSTRAP