
FORM 51 25M 3-49 PETROL KANSAS Stevens

Section 23 Township 32 Range 35-W

Well No. #2 Moore

Company Northern Natural Gas

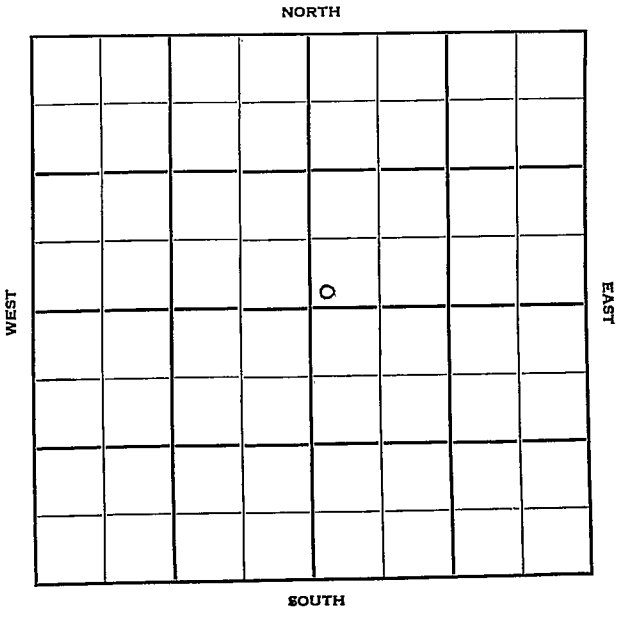

FORM 252-B
10M 9-49 PETROL

Stevens KANSAS

Sec. 23 Twp. 32 R. 35W

Well No. #2 Moore Farm

Northern Natural Gas Company

Contractor

Hugoton Pool


Ft. from N. Line

200' Ft. from S. Line

Ft. from E. Line

200' Ft. from W. Line

SW NE

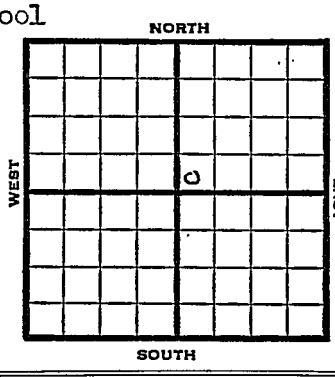

1950	Elev 2983 REPORT
6/28	Location
8/9	10" @ 543 7" @ 2609 TD 2766 Hol 2575 Her 2620 Krider 2685 Win 2720 14000 total acid Comp 13,632,000 open flow 400# Completed **COMPLETED**

FORM 275 FOR SALE BY KANSAS BLUE PRINT CO.


County Stevens State Kansas

Sec. 23 (Blk. Twp.) 32 (Sur. Rge.) 35W Map No.

Operator Northern Natural Gas

Well No. 2 Farm Moore

Elev. 2983 Location SW NE

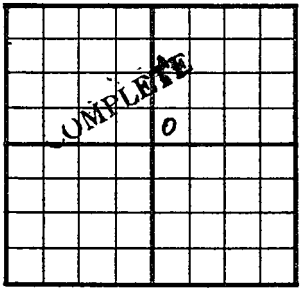

200 Ft. From S Line NE

200 Ft. From W Line Quarter

1st. Report

Completion AUG 9 1950

Remarks

Spudding Date

Drlg. Data

10" @ 543 7" @ 2609 TD 2766

Hol. 2575 Her. 2620 Krider 2685

Win. 2720 14000 total acid

Comp. 13,632,000 open flow 400#

J. E. TYRA

Form 26 200 Bks. 11-49 Petrol

Kansas

Hugoton Pool

Map No. _____ Sec. 23 Twp. 32 R. 35W


Well No. 2 Moore

Northern Natural Gas Company

Contractor

SW NE

SECTION PLAT

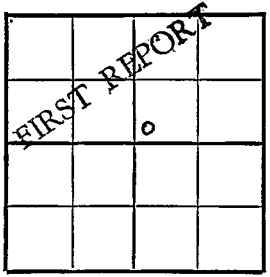

_____ Ft. from N. Line

200 Ft. from S. Line

_____ Ft. from E. Line

200 Ft. from W. Line

Stevens County

Location x

Rig up _____

Drilling and Remarks:

RECORD

Cased _____ in., _____ ft.

Sand _____

Gas _____

Oil _____

Total Depth _____

PRODUCTION

1st 24 hrs. Nat. _____

1st 24 hrs. after shot _____

Gas _____ Cu. Ft.

Dry Hole _____

Abandoned _____

Date

JUN 28 1950 19

J. E. TYRA Scout