

Section 25 Township 32 Range 35-W

Well No. #2 Boles

Company Northern Natural Gas
Hugoton Pool

NORTH

| | | | | | | | |
|--|--|--|--|---|--|--|--|
| | | | | | | | |
| | | | | | | | |
| | | | | | | | |
| | | | | 0 | | | |
| | | | | | | | |
| | | | | | | | |
| | | | | | | | |
| | | | | | | | |

WEST

EAST

SOUTH

Stevens

KANSAS

Sec. 25 Twp. 32 R. 35W

Well No. #2 Boles Farm

Northern Natural Gas Company

Contractor

Hugoton Pool


 Ft. from N. Line

250' Ft. from S. Line

 Ft. from E. Line

250' Ft. from W. Line

SW NE

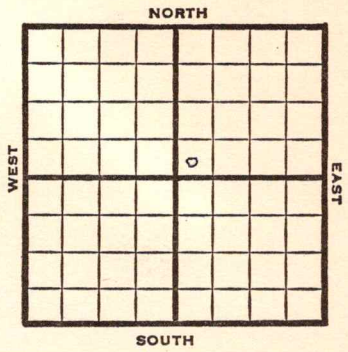

1950

Elev 2953'

REPORT

3/8

Spud 3-6-50
10" @ 536'
WOC

3/29

TD 2735'
10"@ 536'
7"@ 2589'
Herr 2585'
Kridler 2628'
Winfield 2675'
10,760,000 CFGPD
Comp

COMPLETED

Kansas

Map No. _____ Sec. 25 Twp. 32 R. 35W

Well No. 2 Boles

Northern Natural Gas Company

Contractor

SW NE

SECTION PLAT

| | | | |
|--|--|---|--|
| | | | |
| | | o | |
| | | | |
| | | | |
| | | | |

FIRST REPORT

_____ Ft. from N. Line

250 Ft. from S. Line

_____ Ft. from E. Line

250 Ft. from W. Line

Stevens County

RECORD

Location _____

Rig up _____

Drilling and Remarks:

Spud 3-6-50

10" @ 536

WOC

Cased _____ in., _____ ft.

Sand _____

Gas _____

Oil _____

Total Depth _____

PRODUCTION

1st 24 hrs. Nat. _____

1st 24 hrs. after shot _____

Gas _____ Cu. Ft.

Dry Hole _____

Abandoned _____

Date

MAR 8 1950 19

J. E. TYRA

Scout

Kansas

Map No. _____ Sec. 25 Twp. 32 R. 35W

Well No. 2 Boles

Northern Natural Gas Company

Contractor

SW NE

E. 2953
SECTION PLAT

_____ Ft. from N. Line

250 Ft. from S. Line

_____ Ft. from E. Line

250 Ft. from W. Line

| | | | |
|----------|--|---|--|
| COMPLETE | | | |
| | | 0 | |
| | | | |
| | | | |

Stevens County

Location _____

Rig up _____

Drilling and Remarks:

*10" @ 536
7" @ 2589
Levr 2585
Knider 2628
Winfield 2675*

10,760,000

CFGPD

Date

MAR 29 1950

19

RECORD

Cased _____ in., _____ ft.

Sand _____

Gas _____

Oil _____

Total Depth *2735*

PRODUCTION

1st 24 hrs. Nat. _____

1st 24 hrs. after shot _____

Gas _____ Cu. Ft.

Dry Hole _____

Abandoned _____

J. E. TYRA

Scout