
KANSAS

FORM 51 25M 3-49 PETROL

Section 30 Township 32 Range 35 W

Well No. 1 Jenning

Company Northern Natural

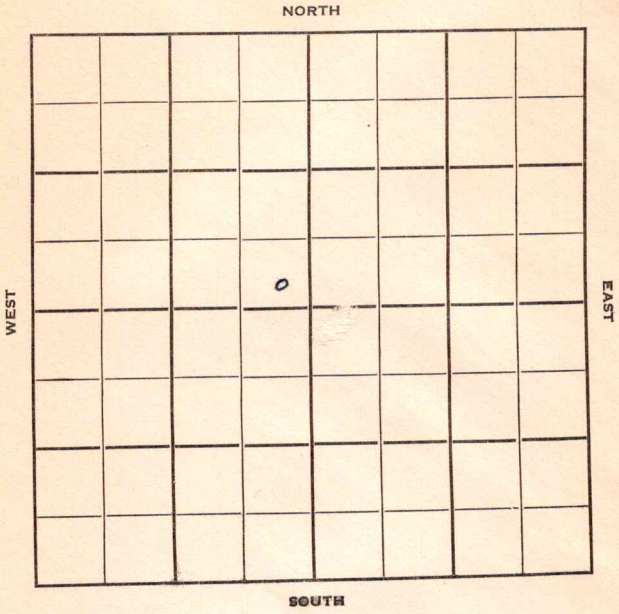

FORM 252-B
10M 9-49 PETROL

Stevens

KANSAS ✓

Sec. 30 Twp. 32 R. 35W

Well No. #1 Jenning Farm

Northern Natural Company

Contractor


Ft. from N. Line

Ft. from S. Line

Ft. from E. Line

Ft. from W. Line

200 N & W of C

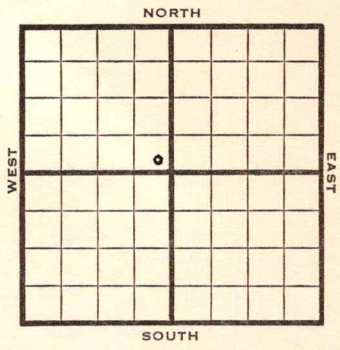

1950	Elev. 3033' REPORT
5/17	Location
6/21	10" @ 631' 7" @ 2628' TD 2810' 207' of 5" Liner Acid 15,000 Comp. opn flow 16,388,000 gas TD 2810' Her 2630' Krider 2690' Win 2735' COMPLETED

Form 26 200 Bks. 11-49 Petrol

Kansas

Map No. _____ Sec. 30 Twp. 32 R. 35W

Well No. 1 Jenning

Northern Natural Company

_____ Contractor

200 N & W of C

_____ Ft. from N. Line

_____ Ft. from S. Line

_____ Ft. from E. Line

_____ Ft. from W. Line

SECTION PLAT



Stevens

Location X

Rig up _____

Drilling and Remarks:

RECORD

Cased _____ in., _____ ft.

Sand _____

Gas _____

Oil _____

Total Depth _____

PRODUCTION

1st 24 hrs. Nat. _____

1st 24 hrs. after shot _____

Gas _____ Cu. Ft.

Dry Hole _____

Abandoned _____

Date

MAY 17 1950

19 _____

J. E. TVRA Scout

Form 26 200 Bks. 11-49 Petrol

Kansas

Map No. _____ Sec. 30 Twp. 32 R. 35W


Well No. 1 Jenning

Northern Natural Company

Contractor

SE NW El. 3033

SECTION PLAT

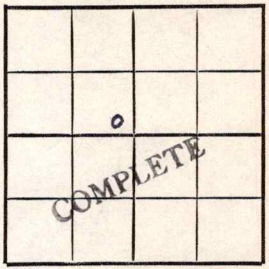

_____ Ft. from N. Line

200 Ft. from S. Line

200 Ft. from E. Line

_____ Ft. from W. Line

Stevens County

Location _____

Rig up _____

Drilling and Remarks:

10" @ 631
7" @ 2628.
TD 2810
207' of 5" liner
15000 acid
Comp. open flow
16,388,000 gas

RECORD

Cased _____ in., _____ ft.

Sand _____

Gas _____

Oil _____

Total Depth 2810

PRODUCTION

1st 24 hrs. Nat. _____

1st 24 hrs. after shot _____

Gas _____ Cu. Ft.

Dry Hole _____

Abandoned _____

Date

JUN 21 1950 19

J. E. TYRA Scout

Her. 2630

Krider 2690

Win. 2735

Scout Cards
Land Small Map
Land Wall Map
Tracings
France Map
Pierce Map
Misc.

JUN 28 1950