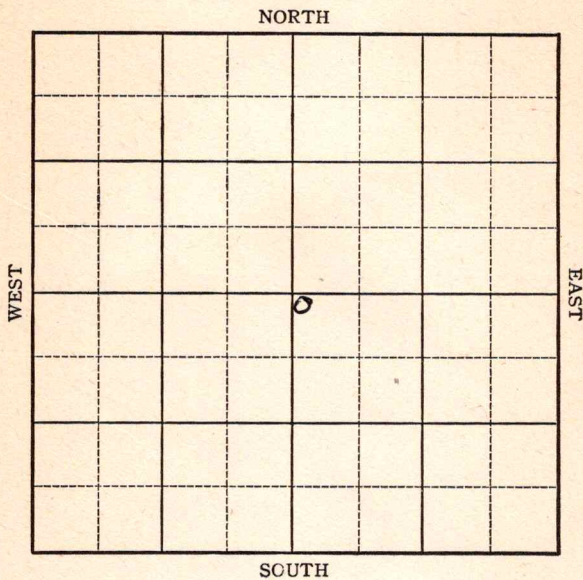


Section 28 Township 32 Range 35WWell No. 1 BrubakerCompany Northern Natural Gas

KANSAS

Stevens County

Sec. 28 Twp. 32 R. 35W

Well No. #1 Brubaker Farm

Northern Natural Gas Company

Hugoton
100

Ft. from N. Line


Ft. from S. Line

Ft. from E. Line

100

Ft. from W. Line

NW SE

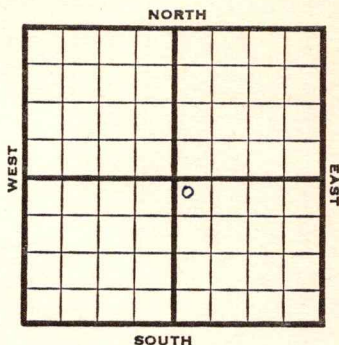

1946 **Elev. 3007** REPORT

5/8 Location
5/14 10" @ 530
Drlg 1900'
5/21 TD 2665-
7" @ 2659
RUST
5/29 TD 2792
149' of 5" perf. liner @ 2792
6/5 16,000 acid.
6/12 " "
6/18 " "
6/26 7" @ 2659
149' of 5" perf. liner @ 2792
16,000 acid.
TD 2792
16,437,000 Gas.
427# RPr.

COMPLETED

Kansas Pool Name HugotonMap No. 10 mg Sec. 28 Twp. 32 R. 35WWell No. 1 BrubakerNorthern Nateral Gas CompanyFIRST REPORT

Contractor

NW SE

SECTION PLAT

100 Ft. from N. Line Ft. from S. Line Ft. from E. Line100 Ft. from W. Line

		o	

Stevens CountyLocation Rig up

Drilling and Remarks:

RECORD

Cased in., ft.Sand Gas Oil Total Depth

PRODUCTION

1st 24 hrs. Nat. 1st 24 hrs. after shot Gas Cu. Ft.Dry Hole Abandoned

Date

MAY 8

1946

19

S. J. LEWIS

Scout

Kansas Pool Name Hugoton Pool

Map No. 10 map Sec. 28 Twp. 32 R. 35W

Well No. 1 Brubaker

Northern Natural Gas Company

COMPLETED

Contractor

NW SE

E. 3007

SECTION PLAT

		6	

100 Ft. from N. Line

 Ft. from S. Line

 Ft. from E. Line

100 Ft. from W. Line

Stevens County

Location

Rig up

Drilling and Remarks:

7" @ 2659

149' of 5" Perf liner

@ 2792

16000 acid

16,437,000 Gas

427 # R/R

RECORD

Cased in., ft.

Sand

Gas

Oil

Total Depth 2792

PRODUCTION

1st 24 hrs. Nat.

1st 24 hrs. after shot

Gas Cu. Ft.

Dry Hole

Abandoned

Date

JUN 26 1946 19 S. J. LEWIS Scout