

Stevens


FORM 51 10M 12-46 PETROL

KANSAS

Section 7 Township 32 Range 36W

Well No. 2 Brubaker

Company Northern Natural Gas

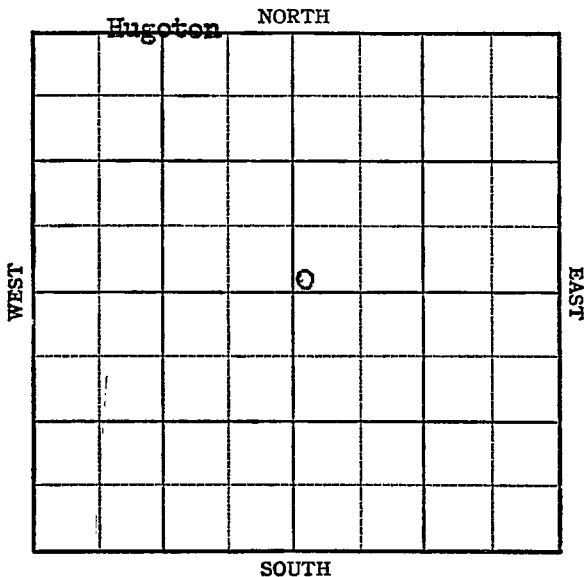

KANSAS

Stevens

Sec. 7 Twp. 32 R. 36WWell No. #2 Brubaker FarmNorthern Natural Gas Company
Hugoton

Ft. from N. Line


100

Ft. from S. Line

Ft. from E. Line

100

Ft. from W. Line

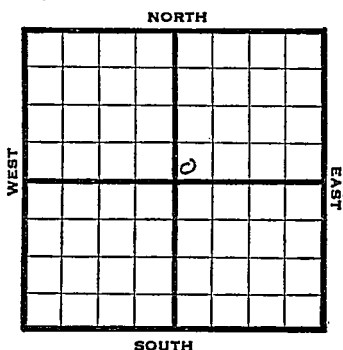

1947

Elev. 3081 REPORT

9/10

10" @ 532
drlg. 2182

9/17

TD 2635'
7" @ 2625'
RUST

9/24

TD 2856'
288' of 5" Perf liner @ 2856'

10/1

"

10/8

"

10/15

"

10/22

"

10/29

7" @ 2625'
238' of 5" Perf liner @ 2856'
14000 Acid
15,067,000 Gas
TD 2856'
413# RPr.**COMPLETED**

Map No. _____ Sec. 7 Twp. 32 R. 36W

Well No. 2 Brubaker


Northern Natural Gas Company

FIRST REPORT

Contractor _____

SW NE

SECTION PLAT

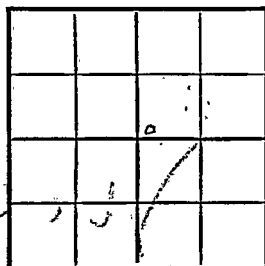

_____ Ft. from N. Line

100 Ft. from S. Line

_____ Ft. from E. Line

100 Ft. from W. Line

Stevens County

Location _____

Rig up _____

Drilling and Remarks:

10" @ 532

drlg. 2182

RECORD

Cased _____ in, _____ ft.

Sand _____

Gas _____

Oil _____

Total Depth _____

PRODUCTION

1st 24 hrs. Nat. _____

1st 24 hrs. after shot _____

Gas _____ Cu.-Ft.

Dry Hole _____

Abandoned _____

Date

SEP 10 1947

19

S. J. LEWIS Scout

Map No. 0 Sec. 7 Twp. 32 R. 36W

Well No. 2 Brubaker

Northern Natural Gas Company

COMPLETE

Contractor

SW NE


E1,308/1
SECTION PLAT

 Ft. from N. Line

100 Ft. from S. Line

 Ft. from E. Line

100 Ft. from W. Line

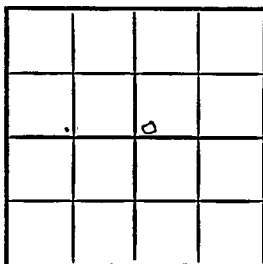

Stevens County

Location

Rig up

Drilling and Remarks:

9' @ 2625

238 1/2' 5" Pay Zone

@ 2856

14000 acc oil

10,067,000 Gas

HKS # RFE

RECORD

Cased in., ft.

Sand

Gas

Oil

Total Depth 2856

PRODUCTION

1st 24 hrs. Nat.

1st 24 hrs. after shot

Gas Cu. Ft.

Dry Hole

Abandoned

Date

OCT 29 1947

19

S. J. LEWIS

Scout