

Stevens


FORM 51 5M BRIX

KANSAS

Section 10 Township 32 Range 36W

Well No. #1 Batman

Company Northern Nat. Gas

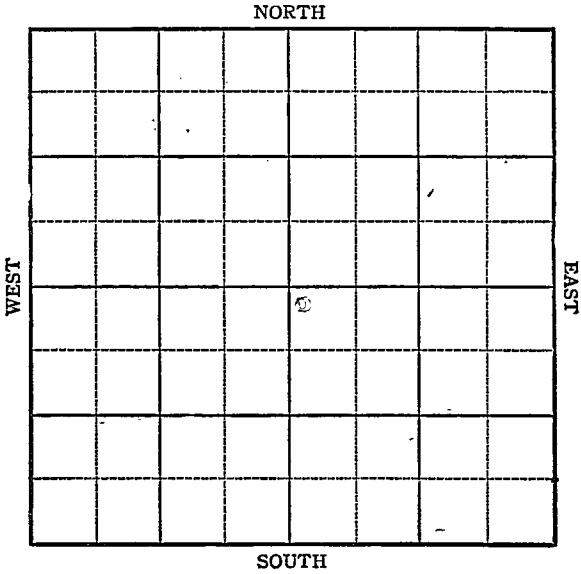

Sec. 10 Twp. 32 R. 36WWell No. #1 Batman Farm


Northern Nat. Gas

Company

Hugoton

100 Ft. from N. Line Ft. from S. Line Ft. from E. Line100 Ft. from W. Line

NW SE

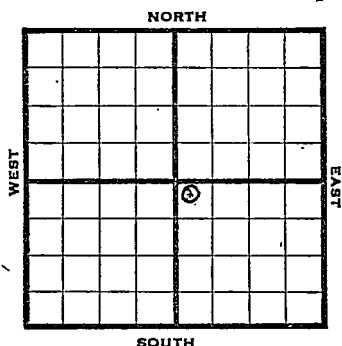

1945 Elev. 3057 R E P O R T

1/24 Material

1/31 Surface hole

2/7 Drlg 610

2/14 10" @ 644

7" @ 2670 RUST

2/21 " " " "

2/28 " " " "

3/7 " " " "

3/14 " " " "

3/23 Drlg. 2782'

3/29 TD 2831

166' of 5" Perf. Liner @ 2831
12000 acid.

4/5 " " " " " " "

4/12 " " " " " " "

4/20 " " " " " " "

4/25 7" @ 2670

166' of 5" Perf. Liner @ 2831

TD 2831'

12000 acid.

19,490,000 Gas

431# R Pr.

COMPLETED

Pool Name HugotonMap No. NM Sec. 10 Twp. 32 R. 36WWell No. 1 BatmanNorthern Nat. Gas Company

FIRST REPORT

Contractor

NW SE

SECTION PLAT

100 Ft. from N. Line Ft. from S. Line Ft. from E. Line100 Ft. from W. Line

		o	

Stevens

Location Rig up

Drilling and Remarks:

material

RECORD

Cased in., ft.Sand Gas Oil Total Depth

PRODUCTION

1st 24 hrs. Nat. 1st 24 hrs. after shot Gas Cu. Ft.Dry Hole Abandoned

Date

JAN 24 1945 19S. J. LEWIS Scout

Kansas Pool Name HugotonMap No. 20-M-40 Sec. 10 Twp. 32 R. 36WWell No. 1 Batman

Northern Nat. Gas. Company


COMPLETED

Contractor

NW SE

E13057

SECTION FLAT

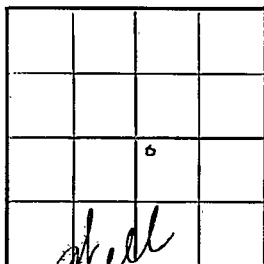100 Ft. from N. Line Ft. from S. Line Ft. from E. Line100 Ft. from W. Line

Stevens County

Location Rig up

Drilling and Remarks:

7' @ 2670
 166' @ 5" Per line
 @ 2831
 12000 @ 2670
 19,496,000 Gas
 431 # R/P

RECORD

Cased in., ft.Sand Gas Oil Total Depth 2831

PRODUCTION

1st 24 hrs. Nat. 1st 24 hrs. after shot Gas Cu. Ft.Dry Hole Abandoned

Date

APR 25 1945 19

S. J. LEWIS

Scout