


Stevens
KANSAS

Section 19 Township 32 Range 36N

Well No. 3 Citizens State Bank

Company Northern Natural Gas

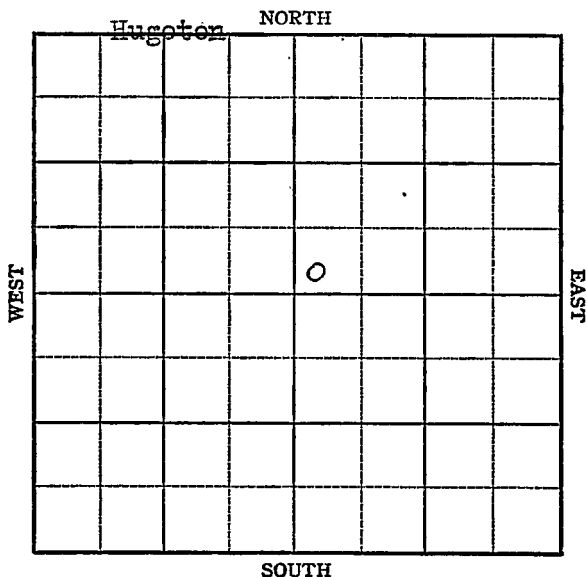

Sec. 19 Twp. 32 R. 36W

Well No. #3 Citizens State Bank Farm

Northern Natural Gas Company

Hugoton


 Ft. from N. Line

100 Ft. from S. Line

 Ft. from E. Line

100 Ft. from W. Line

SW NE

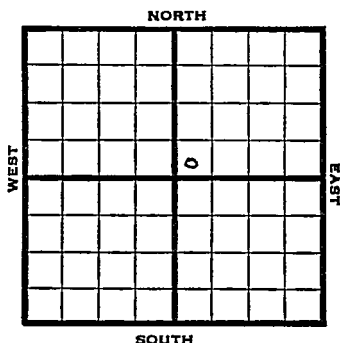

1947	Elev. 3088 REPORT
8/27	Drilg. 712'
9/3	" "
9/10	10" @ 712' TD 2630' 7" @ 2604' RUST
9/17	TD 2808' 211' of 5" Perf. Liner @ 2808'
9/24	15000 Acid
10/1	7" @ 2604 211' of 5" Perf liner @ 2808 15000 acid 31,968,000 Gas TD 2808 382# R Pr.
	COMPLETED

Map No. _____ Sec. 19 Twp. 32 R. 36W

Well No. 3 Citizens State Bank

Northern Natural Gas Company

• **FIRST REPORT**

Contractor

SW NE


SECTION PLAT

Ft. from N. Line

100 Ft. from S. Line

Ft. from E. Line

100 Ft. from W. Line

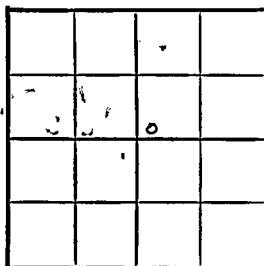

Stevens County

Location _____

Rig up _____

Drilling and Remarks:

drlg, 712

RECORD

Cased _____ in., _____ ft.

Sand _____

Gas _____

Oil _____

Total Depth _____

PRODUCTION

1st 24 hrs. Nat. _____

1st 24 hrs. after shot _____

Gas _____ Cu. Ft.

Dry Hole _____

Abandoned _____

Date

AUG 27 1947 19

S. J. LEWIS

Scout

Map No. 1 Sec. 19 Twp. 32 R. 36W

Well No. 3 Citizen State Bank

Northern Natural Gas Company

COMPLETE

Contractor

SW NE

L. 1,3088


SECTION PLAT

 Ft. from N. Line

100 Ft. from S. Line

 Ft. from E. Line

100 Ft. from W. Line

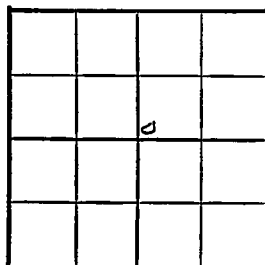

Stevens County

Location

Rig up

Drilling and Remarks:

7' C2604

211' 2 1/2" Pay liner

Q2508

15000 acid

31,968,000 Gas

382 in R/A

RECORD

Cased in., ft.

Sand

Gas

Oil

Total Depth 2805

PRODUCTION

1st 24 hrs. Nat.

1st 24 hrs. after shot

Gas Cu. Ft.

Dry Hole

Abandoned

Date

OCT 1 1947 19 S. J. LEWIS Scout