

KANSAS


FORM 51 5M PETROL

Stevens

Section 21 Township 32 Range 36 W
36 W

Well No. #1 Kenoyer

Company Northern Nat'l Gas

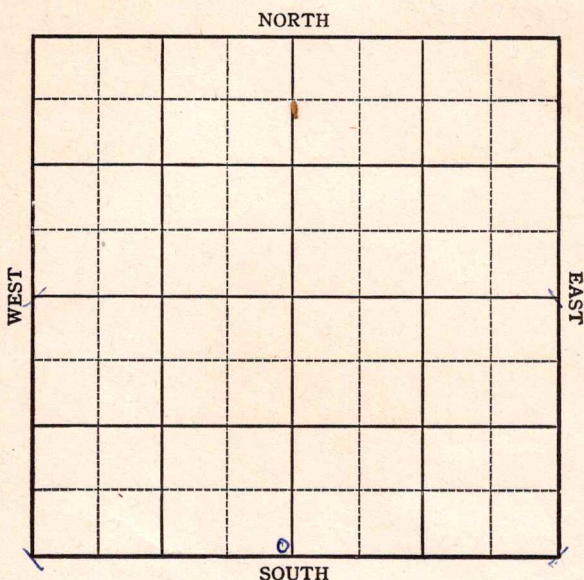


Sec. 21 Twp. 32 R. 36-WWell No. #1 Kenoyer FarmNorthern Nat'l Gas Company

_____ Ft. from N. Line

100 Ft. from S. Line

100 Ft. from E. Line

_____ Ft. from W. Line

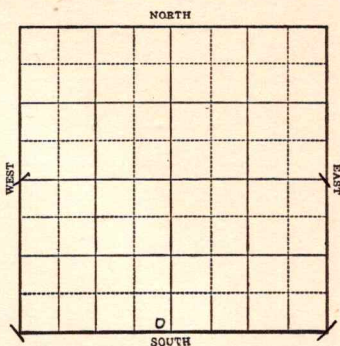

1943

R E P O R T

9/22	Location
9/29	"
10/6	ROG
10/13	"
10/20	10" @ 582'
	WOC.
10/27	Kind 2670
	7" @ 2674
	Rust
11/3	T.D. 2675
	Rust
11/10	"
11/17	" "
11/24	2678 TD RUST
12/1	" "
12/8	TD 2829
	7 M gas
	1300 acid
12-15	2000 acid
	24,284,000 gas
12/22	" "
12/29	" "
1944	
1-5	" "
1-12	" "
1/19	" "

OVER

1944

1/26

7" @ 2672

~~Kinder~~ 2670

TD 2829

1500 acid


34.987,000 mgas.

COMPLETED

KANSAS
Map No. MM Sec. 21 Twp. 32 R. 36WWell No. 1 KenoyerNorthern Nat'l Gas CompanyFIRST REPORT Contractor

SE SW

SECTION PLAT

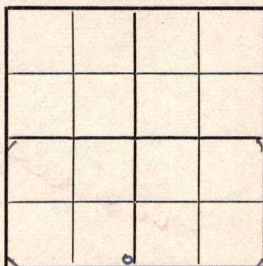 Ft. from N. Line100 Ft. from S. Line100 Ft. from E. Line Ft. from W. LineHoughton Gas PoolLocation XRig up

Drilling and Remarks:

RECORD

Cased in., ft.Sand Gas Oil Total Depth

PRODUCTION

1st 24 hrs. Nat. 1st 24 hrs. after shot Gas Cu. Ft.Dry Hole Abandoned

Date

SEP 22 1943 19 S. J. LEWIS Scout

KANSAS
 Map No. WM Sec. 21 Twp. 32 R. 36W

Well No. 1 Kenoyer

Northern Nat'l Gas Company

COMPLETED

Contractor

SE SW

SECTION PLAT

Ft. from N. Line

100

Ft. from S. Line

100

Ft. from E. Line

Ft. from W. Line

Houghton Gas Pool

Location

Rig up

Drilling and Remarks:

Krieger 2670

7" @ 2672

15000 @ 2672

34, 989,000 Gas

RECORD

Cased _____ in., _____ ft.

Sand _____

Gas _____

Oil _____

Total Depth 2827

PRODUCTION

1st 24 hrs. Nat. _____

1st 24 hrs. after shot _____

Gas _____ Cu. Ft.

Dry Hole _____

Abandoned _____

Date

JAN 26 1944 19

S. J. LEWIS Scout