KANSAS


Stevens

FORM 51 5M 6-46 PETROL

Section 32 Township 32 Range 36-W

Well No. #1 Jordan

Company Northern Natural Gas

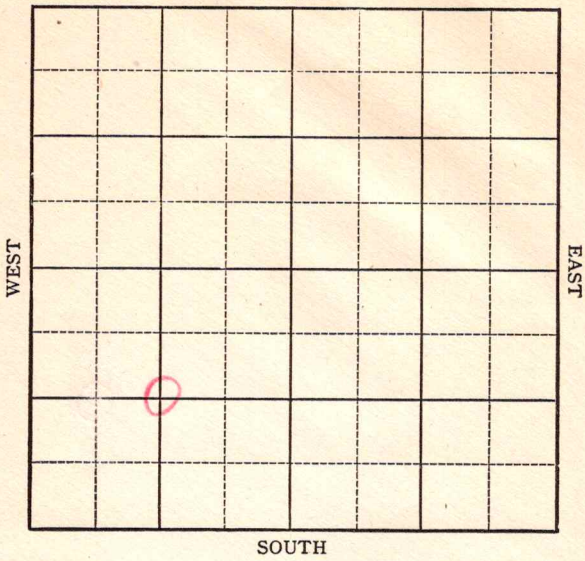

FORM 252-A
5M 6-46 PETROL

KANSAS Stevens County

Sec. 32 Twp. 32 R. 36W

Well No. #1 Jordan Farm

Northern Natural Gas Company

Hugoton


_____ Ft. from N. Line

1320 Ft. from S. Line

1320 Ft. from E. Line

_____ Ft. from W. Line

C SW

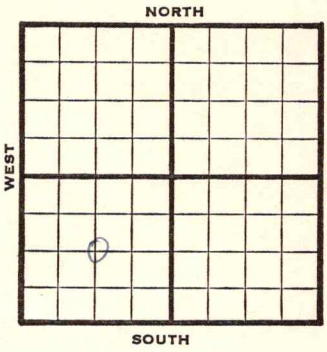

1946	3068 REPORT
7/3	10" @ 563' WOC
7/9	Drlg 2500'
7/16	TD 2715 7" @ 2619'
7/23	TD 2830 222' of 5" Perf liner @ 2830 14000 acid
7/30	" " "
8/6	" " "
8/13	" " "
8/21	7" @ 2619 222' of 5" perf. liner @ 2830 14,000 acid. TD 2830' 28,172,000 Gas 392# R Pr.

COMPLETED

FORM 26 200 BKS 2-44 PETROL

Kansas Pool Name Hugoton

Map No. no map Sec. 32 Twp. 32 R. 36W


Well No. 1 Jordan

Northern Natural Gas Company

FIRST REPORT Contractor

C/SW

SECTION PLAT

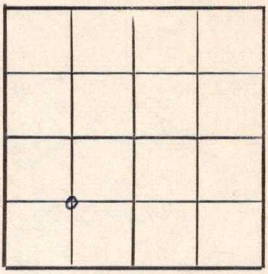

____ Ft. from N. Line

1320 Ft. from S. Line

1320 Ft. from E. Line

____ Ft. from W. Line

Stevens County

Location

Rig up

Drilling and Remarks:

10" @ 563' WOC

RECORD

Cased ____ in., ____ ft.

Sand

Gas

Oil

Total Depth

PRODUCTION

1st 24 hrs. Nat.

1st 24 hrs. after shot

Gas ____ Cu. Ft.

Dry Hole

Abandoned

Date

JUL 3 1946 19

S. J. LEWIS Scout

FORM 56 200 BKS, 1-44 PETROL

KANSAS

Kansas

Pool Name Hugoton

Map No. Sec. 32 Twp. 32 R. 36W

Well No. 1 Jordan


Northern Natural Gas Company

COMPLETED Contractor

C SW

E 1,3068

SECTION PLAT

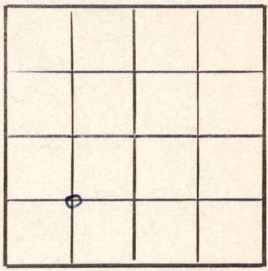

Ft. from N. Line

1320 Ft. from S. Line

1320 Ft. from E. Line

Ft. from W. Line

Stevens County

Location

Rig up

Drilling and Remarks:

7" @ 2619

222' of 5" Perf

Liner @ 2880

14000 Acid

28,172,000 Gas

892 MCFPD

RECORD

Cased in, ft.

Sand

Gas

Oil

Total Depth 2880

PRODUCTION

1st 24 hrs. Nat.

1st 24 hrs. after shot

Gas Cu. Ft.

Dry Hole

Abandoned

Date

AUG 21 1946 19 S. J. LEWIS Scout