


KANSAS Stevens

Section 3 Township 32 Range 36W

Well No. 1 Barngrover

Company Northern Nat Gas

Hugoton
NORTH

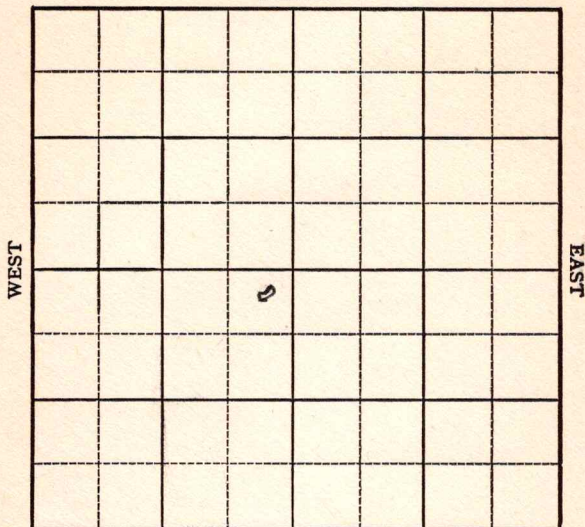

SOUTH

KANSAS

Stevens



Sec. 3 Twp. 32 R. 36W

Well No. #1 Barngrover Farm

Northern Nat. Gas

Company


Hugoton

200' Ft. from N. Line

 Ft. from S. Line

200' Ft. from E. Line

 Ft. from W. Line

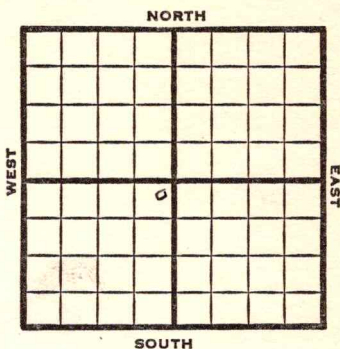

NE SW

1949

Elev. 3059'

REPORT

2/9	Surface Hole
2/16	10" @ 697'
	TD 2626'
	Run 7"
2/23	7" @ 2619'
	Drlg. 2775'
3/2	TD 2848'
	227' of 5" Perf liner @ 2848'
3/8	"
3/16	"
3/23	12000 acid
3/30	7" @ 2619'
	237' of 15" Perf liner @ 2848'
	Acid 18,000
	Gas 23,862,000
	R.Pr. 419#
	TD 2848'

COMPLETED

Kansas

Hugoton

Map No. _____ Sec. 3 Twp. 32 R. 36 WWell No. 1 BarnycorenNorthern Nat. Gas

Company

FIRST REPORT

Contractor

NE SW

SECTION PLAT

	0		

200 Ft. from N. Line

_____ Ft. from S. Line

200 Ft. from E. Line

_____ Ft. from W. Line

Stevens

Location _____

Rig up _____

Drilling and Remarks:

SH

RECORD

Cased _____ in., _____ ft.

Sand _____

Gas _____

Oil _____

Total Depth _____

PRODUCTION

1st 24 hrs. Nat. _____

1st 24 hrs. after shot _____

Gas _____ Cu. Ft.

Dry Hole _____

Abandoned _____

Date

FEB 9 1949 19

S. J. LEWIS

Scout

KANSAS

Map No. _____ Sec. 3 Twp. 32 R. 36WWell No. 1 Barngrover

Northern Natural Gas

Company

COMPLETE

Contractor

NE SW


E 1,305' SECTION PLAT

200 Ft. from N. Line

_____ Ft. from S. Line

200 Ft. from E. Line

_____ Ft. from W. Line

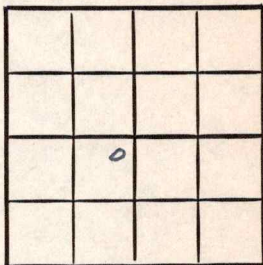

Stevens County

Location _____

Rig up _____

Drilling and Remarks:

9" 02619
 237' 5" Pay/line
 0-2548
 15000 acid
 25, 522, 000 Bar
 419 * R/P

RECORD

Cased _____ in., _____ ft.

Sand _____

Gas _____

Oil _____

Total Depth 2848

PRODUCTION

1st 24 hrs. Nat. _____

1st 24 hrs. after shot _____

Gas _____ Cu. Ft.

Dry Hole _____

Abandoned _____

Date

MAR 30 1949

19

S. J. LEWIS

Scout