
Stevens KANSAS

FORM 51 25M 3-49 PETROL

Section 1 Township 32 Range 36W

Well No. #1 Dudley

Company Northern Natural Gas

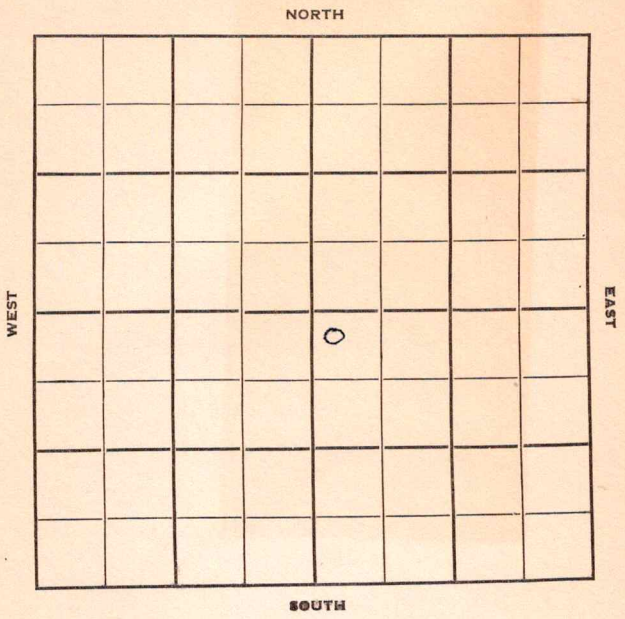

FORM 252-B
10M 9-49 PETROL

Stevens KANSAS

Sec. 1 Twp. 32 R. 36W

Well No. #1 Dudley Farm

Northern Natural Gas Company

Contractor

Hugoton Pool


200' Ft. from N. Line

Ft. from S. Line

Ft. from E. Line

200' Ft. from W. Line

NW SE

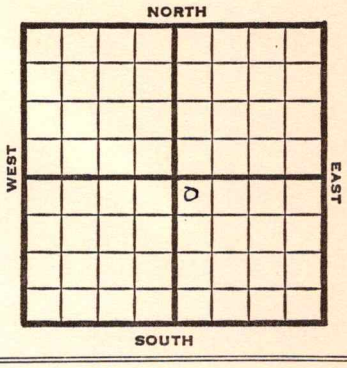

1950	Elev 3049' REPORT
3/29	Spud 3-27-50 Drlg. 580'
4/26	TD 2820' 10"@ 550' 7"@ 2598' TD 2820' 233' of 5" liner 13000 A Herington 2600' Krider 2670' Winfield 2718' Ft Riley 2782' Comp 23,346,000 Gas open flow Comp

COMPLETED

Form 26 200 Bks. 11-49 Petrol

Kansas Hugoton Pool

Map No. _____ Sec. 1 Twp. 32 R. 36W

Well No. 1 Dudley

Northern Natural Gas Company

Contractor

NW SE

200 Ft. from N. Line


_____ Ft. from S. Line

_____ Ft. from E. Line

200 Ft. from W. Line

Stevens County

SECTION PLAT

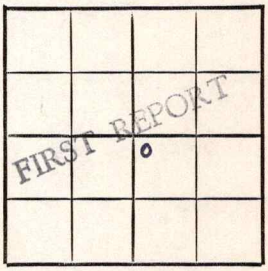

Location _____

Rig up _____

Drilling and Remarks:

Spud 3-27-50

drlg. 580

RECORD

Cased _____ in., _____ ft.

Sand _____

Gas _____

Oil _____

Total Depth _____

PRODUCTION

1st 24 hrs. Nat. _____

1st 24 hrs. after shot _____

Gas _____ Cu. Ft.

Dry Hole _____

Abandoned _____

Date

MAR 29 1950 19 J. E. TYRA Scout

Form 26 200 Bks. 11-49 Petrol

Kansas

Hugoton Pool

Map No. _____ Sec. 1 Twp. 32 R. 36W

Well No. 1 Dudley


Northern Natural Gas Company

Contractor

NW SE

El. 3049

SECTION PLAT

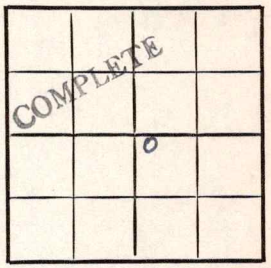

200 Ft. from N. Line

Ft. from S. Line

Ft. from E. Line

200 Ft. from W. Line

Stevens County

Location

Rig up

Drilling and Remarks:

10" @ 550
7" @ 2598
T.D. 2820
233' of 5" liner
1300 A
Hexington 2600

RECORD

Cased in., ft.

Sand

Gas

Oil

Total Depth 2820

PRODUCTION

1st 24 hrs. Nat.

1st 24 hrs. after shot

Gas Cu. Ft.

Dry Hole

Abandoned

Date

APR 26 1950 19

J. E. TYRA Scout

Rider 2670
Winfield 2718
Ft. Riley 2782
Comp. 23, 346,000 gas, open flow

Scout Cards
Land Small Map
Land Wall Map
Tracings
France Map
Pierce Map
Misc.

MAY 3 1950