


Section 31 Township 32 Range 36-W

Well No. #1 Morehead

Company Northern Natural Gas

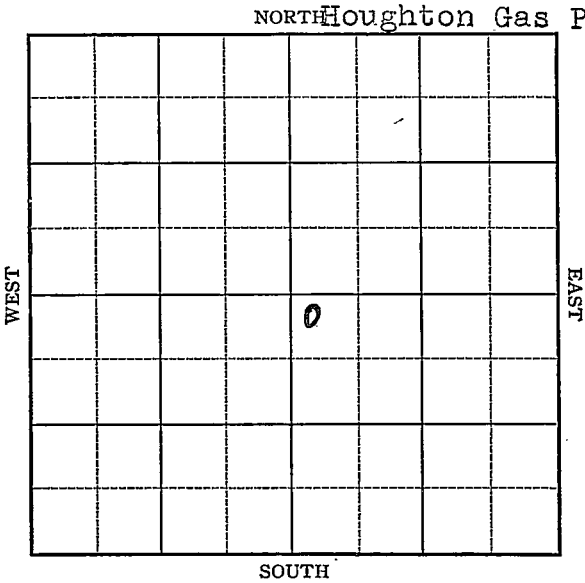

KANSAS

Stevens

Sec. 31 Twp. 32 R. 36-~~W~~

Well No. #1 Morehead Farm

Northern Natural Gas Company


(Houghton)

100 Ft. from N. Line

         Ft. from S. Line

         Ft. from E. Line

100 Ft. from W. Line

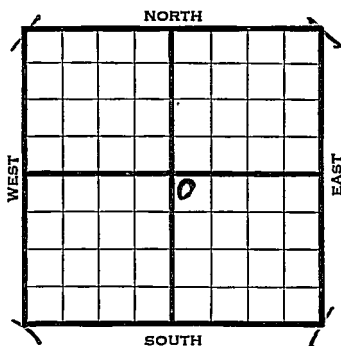


| 1942 | REPORT                    |  |
|------|---------------------------|--|
| 6/10 | Location                  |  |
| 6/24 | "                         |  |
| 7/1  | "                         |  |
| 7/8  | "                         |  |
| 7/15 | "                         |  |
| 7/22 | Derrick                   |  |
| 7/29 | "                         |  |
| 8/5  | 10" - 600'                |  |
|      | 7" - 2661 RUST            |  |
| 8/12 | " "                       |  |
| 8/19 | TD 2844 - 3 M Gas         |  |
| 8/27 | TD 2850 4 M Gas 1000 acid |  |
| 9/2  | Sand. 2661 7" - 2661      |  |
|      | 1000 acid                 |  |
|      | T.D. 2850                 |  |
|      | 20.8 M Gas                |  |
|      | COMPLETED                 |  |
|      |                           |  |
|      |                           |  |
|      |                           |  |
|      |                           |  |

Map No. N/M Sec. 31 Twp. 32 R. 36WWell No. 1 MoreheadNorthern Natural Gas CompanyFIRST REPORT Contractor

NW SE

## SECTION PLAT

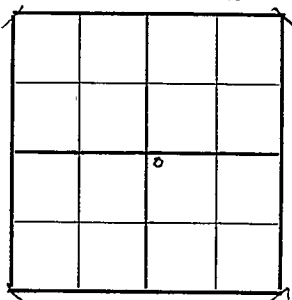100 Ft. from N. Line       Ft. from S. Line       Ft. from E. Line100 Ft. from W. LineHOUGHTON GAS POOLLocation XXXRig up       

Drilling and Remarks:

## RECORD

Cased        in.,        ft.Sand       Gas       Oil       Total Depth       

## PRODUCTION

1st 24 hrs. Nat.       1st 24 hrs. after shot       Gas        Cu. Ft.Dry Hole       Abandoned       

Date

JUN 10 1942 19S. J. LEWIS Scout

Map No. MM Sec. 31 Twp. 32 R. 36WWell No. 1 Morehead

Northern Natural Gas Company

**COMPLETED**

Contractor

NW SE

## SECTION PLAT

100 Ft. from N. Line       Ft. from S. Line       Ft. from E. Line100 Ft. from W. Line

|  |  |   |  |
|--|--|---|--|
|  |  |   |  |
|  |  |   |  |
|  |  | o |  |
|  |  |   |  |

## HOUGHTON GAS POOL

Location                                 Rig up                                 

Drilling and Remarks:

*Sand 2661**7" @ 2661**10000 acro'l**20% M Gas*

## RECORD

Cased            in.,            ft.Sand                                 Gas                                 Oil                                 Total Depth 2850

## · PRODUCTION

1st 24 hrs. Nat.                                 1st 24 hrs. after shot                                 Gas                                  Cu. Ft.Dry Hole                                 Abandoned                                 

Date

SEP 2 1942 19

S. J. LEWIS Scout