



Stevens

FORM 51 25M 3-49 PETROL

Section 5 Township 32 Range 37W

Well No. 1 Robinson

Company Hugoton Prod.

Hugoton
NORTH

WEST

EAST

							/
				0			

SOUTH

KANSAS

Stevens

Sec. 5 Twp. 32 R. 37W ✓

Well No. #1 Robinson Farm

Hugoton Prod. Company

Hugoton Pool


NORTH

117' Ft. from N. Line

Ft. from S. Line

Ft. from E. Line

105' Ft. from W. Line

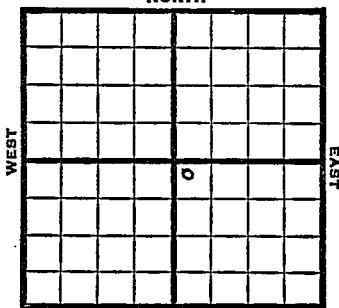

NW SE

SOUTH

1949 Elev 3149' REPORT

4/20	Location
4/27	"
5/4	"
5/10	"
5/18	10" @ 623' rlg 1500'
5/25	TD 2538' 7" @ 2533'
6/1	TD 2775' 258' of 5" Perf liner @ 2775'
6/7	"
6/15	"
6/21	"
6/29	TD 2775' 7" @ 2533' 258' of 5" Perf Liner @ 2775' 2,620,000 Gas 398# R Pr. Comp

COMPLETED

Map No. _____ Sec. 5 Twp. 32 R. 37WWell No. 1 RobinsonHugoton Prod.

Company

FIRST REPORT

Contractor

NW SE

SECTION PLAT

112 Ft. from N. Line125 Ft. from S. Line

_____ Ft. from E. Line

105 Ft. from W. Line

		6	

Stevens County

Location X

Rig up _____

Drilling and Remarks:

• RECORD

Cased _____ in., _____ ft.

Sand _____

Gas _____

Oil _____

Total Depth _____

PRODUCTION

1st 24 hrs. Nat. _____

1st 24 hrs. after shot _____

Gas _____ Cu. Ft.

Dry Hole _____

Abandoned _____

Date

APR 20 1949

19

S. J. LEWIS

Scout

Map No. ✓ Sec. 5 Twp. 32 R. 37W

Well No. 1 Robinson

Hugoton Prod. Company

COMPLETE

Contractor

NW SE

E1,3149
SECTION PLAT

117 Ft. from N. Line

 Ft. from S. Line

 Ft. from E. Line

105 Ft. from W. Line

		0	

Stevens County

Location

Rig up

Drilling and Remarks:

7" C2533

208' of 15" Pay line

C2725

2,620,000 gal.

3984212

RECORD

Cased in., ft.

Sand

Gas

Oil

Total Depth 2725

PRODUCTION

1st 24 hrs. Nat.

1st 24 hrs. after shot

Gas Cu. Ft.

Dry Hole

Abandoned

Date

JUN 29 1949

19

S. J. LEWIS

Scout