


Stevens

FORM 51 5M 4-41 PETROL **KANSAS**

Section 25 Township 32 Range 37-W


Well No. #1 Lightcap

Company Northern Natural Gas
(Misc.)

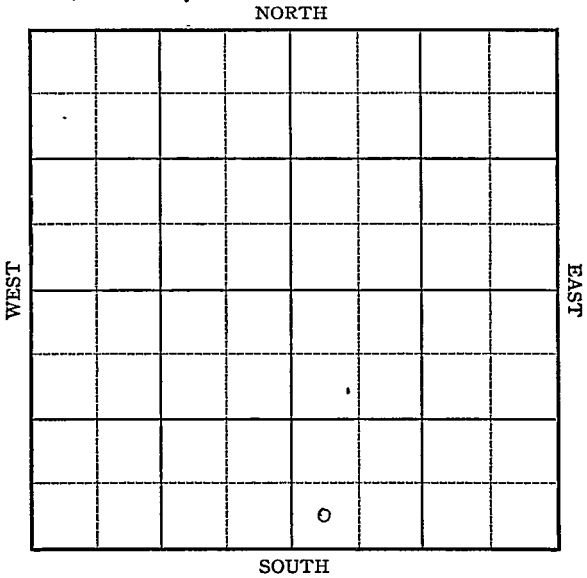

Sec. 25 Twp. 32 R. 37WWell No. #1 Lightcap FarmNorthern Natural Gas Company

(Miscellaneous)

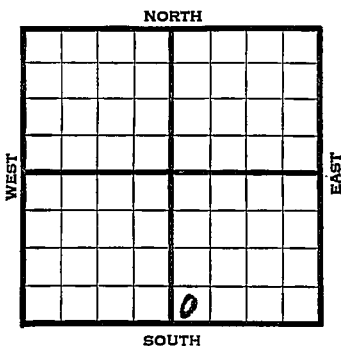 Ft. from N. Line330 Ft. from S. Line Ft. from E. Line330 Ft. from W. Line

1941	REPORT
7/23	Rotary
7/31	10" @ 630 WOC.
8/7	" " " "
8/15	7" 2657 Dlg. 2670'
8/21	" " "
8/28	T.D. 2845' 5,8 M gas.
	10,000 acid.
9/4	" "
9/11	" "
9/18	" "
9/24	Sand 2651'
	7" - 2651'
	T.D. 2845'
	10,000 acid.
	31 M gas.
	COMPLETED

Map No. NM Sec. 25 Twp. 32 R. 37WWell No. 1 LightcapNorthern Natural Gas CompanyFIRST REPORT Contractor

SW SE

Ft. from N. Line

330 Ft. from S. Line

Ft. from E. Line

330 Ft. from W. Line

SECTION PLAT

MISCELLANEOUS

Location _____

Rig up _____

Drilling and Remarks:

Rotary

RECORD

Cased _____ in., _____ ft.

Sand _____

Gas _____

Oil _____

Total Depth _____

PRODUCTION

1st 24 hrs. Nat. _____

1st 24 hrs. after shot _____

Gas _____ Cu. Ft.

Dry Hole _____

Abandoned _____

Date

JUL 23 1941 19S. J. LEWIS Scout

Map No. — Sec. 25 Twp. 32 R. 37W

Well No. 1 Lightcap

Northern Natural Gas Company

COMPLETED Contractor

SW SE

Ft. from N. Line

330 Ft. from S. Line

Ft. from E. Line

330 Ft. from W. Line

SECTION PLAT

MISCELLANEOUS

Location

Rig up

Drilling and Remarks:

Sec 26 51
 2" @ 2651
 10000 ac @ 6
 31 M Gas

RECORD

Cased in., ft.

Sand

Gas

Oil

Total Depth 2845

PRODUCTION

1st 24 hrs. Nat.

1st 24 hrs. after shot

Gas Cu. Ft.

Dry Hole

Abandoned

Date

SEP 24 1941

19

S. J. LEWIS

Scout