

CONFIDENTIAL

ORIGINAL

RELEASED

MAY 18 1999

FROM CONFIDENTIAL

SCIENTIFIC DRILLING

OKLAHOMA CITY OK

Well Name : McCLURE 4-A
 Location : STEVENS CO. KANSAS
 SHL :
 BHL :
 ACTUAL BHL :
 : DECEMBER 10 1997
 : 34H1297424
 Survey Performed By : MIKE McSPERITT AND JOE NORRIS

REC'D
 MAY 22 1999

This survey is correct to the best of my knowledge and is supported by actual field data.

Mauro, [Signature]
 COMPANY REPRESENTATIVE

CONFIDENTIAL

ORIGINAL

RELEASED

MAY 18 1999

FROM CONFIDENTIAL

SCIENTIFIC DRILLING

:
 Well Name : McCLURE 4-A
 Location : STEVENS CO. KANSAS
 SHL :
 BHL :
 ACTUAL BHL :
 Height Of WELLSITE Datum Above Field Datum 0.00 ft

Page 1 of 1
 Date DECEMBER 10 1997
 Filename : MCCLURE

No Interpolation

MD	INC	DIR	TVD	LAT	DEP	VS	D'LEG	BUILD	TURN	TOOL	C\I
ft	deg	deg	ft	ft	ft	ft	°/100	°/100	°/100		ft
2271	0.9	177.9	2270	-4	49	-49	0.0	0.0	0.0		0
2304	2.8	264.0	2303	-4	48	-48	8.9	6.1	99.0		33
2335	8.2	275.3	2334	-4	45	-45	17.5	17.3	36.5		31
2365	14.0	277.8	2363	-4	39	-39	19.4	19.3	8.3		30
2397	20.4	277.4	2394	-2	30	-30	20.0	20.0	-1.3		32
2429	25.0	276.0	2423	-1	18	-18	14.5	14.4	-4.4		32
2460	29.8	277.0	2451	1	3	-3	15.6	15.5	3.2		31
2489	30.2	277.0	2476	2	-11	11	1.4	1.4	0.0		29
2521	33.6	276.0	2503	4	-28	28	10.8	10.6	-3.1		32
2552	39.3	275.0	2528	6	-46	46	18.5	18.4	-3.2		31
2583	44.9	273.0	2551	7	-67	67	18.6	18.1	-6.5		31
2613	46.5	273.0	2572	9	-88	88	5.3	5.3	0.0		30
2645	46.6	273.0	2594	10	-111	111	0.3	0.3	0.0		32
2676	51.1	272.0	2614	11	-135	135	14.7	14.5	-3.2		31
2707	57.0	270.0	2633	11	-160	160	19.7	19.0	-6.5		31
2738	63.8	270.0	2648	11	-187	187	21.9	21.9	0.0		31
2770	69.8	270.0	2660	11	-216	216	18.8	18.8	0.0		32
2801	72.0	270.0	2671	11	-246	246	7.1	7.1	0.0		31
2833	72.2	270.0	2680	11	-276	276	0.6	0.6	0.0		32
2865	75.2	270.0	2689	11	-307	307	9.4	9.4	0.0		32
2896	81.6	270.0	2696	11	-337	337	20.6	20.6	0.0		31
2942	90.4	270.0	2699	11	-383	383	19.1	19.1	0.0		46
2974	91.2	270.0	2698	11	-415	415	2.5	2.5	0.0		32
3005	91.3	270.0	2698	11	-446	446	0.3	0.3	0.0		31
3037	91.5	270.0	2697	11	-478	478	0.6	0.6	0.0		32
3069	91.5	270.0	2696	11	-510	510	0.0	0.0	0.0		32
3100	91.5	270.0	2695	11	-541	541	0.0	0.0	0.0		31
3132	91.2	270.0	2695	11	-573	573	0.9	-0.9	0.0		32
3164	90.8	270.0	2694	11	-605	605	1.3	-1.2	0.0		32
3195	90.5	270.0	2694	11	-636	636	1.0	-1.0	0.0		31
3227	90.8	270.0	2693	11	-668	668	0.9	0.9	0.0		32
3258	91.0	270.0	2693	11	-699	699	0.6	0.6	0.0		31
3290	91.0	270.0	2692	11	-731	731	0.0	0.0	0.0		32
3322	89.9	270.0	2692	11	-763	763	3.4	-3.4	0.0		32
3354	90.2	270.0	2692	11	-795	795	0.9	0.9	0.0		32
3385	91.0	270.0	2692	11	-826	826	2.6	2.6	0.0		31

MAY 2

3449	89.7	270.0	2691	11	-890	890	3.1	-3.1	0.0	32
3481	89.6	270.0	2691	11	-922	922	0.3	-0.3	0.0	32
3513	89.8	270.0	2691	11	-954	954	0.6	0.6	0.0	32
3544	89.2	270.0	2692	11	-985	985	1.9	-1.9	0.0	31
3576	88.5	270.0	2692	11	-1017	1017	2.2	-2.2	0.0	32
3608	88.1	270.0	2693	11	-1049	1049	1.3	-1.2	0.0	32
3640	88.0	270.0	2694	11	-1081	1081	0.3	-0.3	0.0	32
3672	87.9	270.0	2695	11	-1113	1113	0.3	-0.3	0.0	32
3704	87.7	270.0	2697	11	-1145	1145	0.6	-0.6	0.0	32
3736	87.1	270.0	2698	11	-1177	1177	1.9	-1.9	0.0	32
3768	87.6	270.0	2700	11	-1209	1209	1.6	1.6	0.0	32
3800	87.5	270.0	2701	11	-1241	1241	0.3	-0.3	0.0	32
3831	88.1	270.0	2702	11	-1272	1272	1.9	1.9	0.0	31
3863	88.5	270.0	2703	11	-1304	1304	1.3	1.2	0.0	32
3895	88.5	270.0	2704	11	-1336	1336	0.0	0.0	0.0	32
3927	89.6	270.0	2704	11	-1368	1368	3.4	3.4	0.0	32
3959	90.4	270.0	2704	11	-1400	1400	2.5	2.5	0.0	32
3991	91.4	270.0	2704	11	-1432	1432	3.1	3.1	0.0	32
4023	90.9	270.0	2703	11	-1464	1464	1.6	-1.6	0.0	32
4054	90.8	270.0	2703	11	-1495	1495	0.3	-0.3	0.0	31
4086	91.2	270.0	2702	11	-1527	1527	1.3	1.2	0.0	32
4117	91.6	270.0	2702	11	-1558	1558	1.3	1.3	0.0	31
4147	91.1	270.0	2701	11	-1588	1588	1.7	-1.7	0.0	30
4179	90.5	270.0	2700	11	-1620	1620	1.9	-1.9	0.0	32
4211	89.9	270.0	2700	11	-1652	1652	1.9	-1.9	0.0	32
4238	89.3	270.0	2700	11	-1679	1679	2.2	-2.2	0.0	27
4269	89.3	270.0	2701	11	-1710	1710	0.0	0.0	0.0	31
4301	90.1	270.0	2701	11	-1742	1742	2.5	2.5	0.0	32
4333	90.1	270.0	2701	11	-1774	1774	0.0	0.0	0.0	32
4364	90.6	270.0	2701	11	-1805	1805	1.6	1.6	0.0	31
4396	90.4	270.0	2701	11	-1837	1837	0.6	-0.6	0.0	32
4438	90.4	270.0	2700	11	-1879	1879	0.0	0.0	0.0	42

Origin of Bottom Hole Closure SLOT
Bottom Hole Closure 1879 ft 270.3°

THANK YOU FOR THE WORK ,MIKE

RELEASED

ORIGINAL

MAY 18 1999 Goolsby Brothers & Assoc., Survey Report

MIN. CURVATURE CALCULATIONS (SPE-3362)

15-189-22262-0100

OPERATOR: ANADARKO PETROLEUM CORP. START: 12-Dec-97 (kick-off)
 WELL: McClure A-4 FINISH: 20-Dec-97
 LOCATION: STEVENS COUNTY, KANSAS Tool Length 42 ft
 ELEVATIC 3203 (KB)

KCC

APR 3

CONFIDENTIAL

PROP. DIRECTION 270


CONFIDENTIAL

SURVEY NUMBER	MD	INC	TRUE AZM	TVD	N-S	E-W	SECT	DLS/100	SUB-SEA AT TVD
TIE IN	0.0	0.0	0.0	0.0	0.0	0.0	0.0	0.0	3203.0
2	99.9	0.2	166.9	99.9	-0.1	0.0	0.0	0.2	3103.1
3	199.8	0.1	206.2	199.8	-0.3	0.0	0.0	0.1	3003.2
4	299.6	0.6	74.3	299.6	-0.2	0.5	-0.5	0.6	2903.4
5	399.9	1.7	80.6	399.9	0.2	2.4	-2.4	1.1	2803.1
6	499.7	2.2	77.9	499.6	0.8	5.8	-5.8	0.6	2703.4
7	599.9	2.4	77.1	599.7	1.7	9.7	-9.7	0.1	2603.3
8	699.1	2.6	87.4	698.8	2.2	13.9	-13.9	0.5	2504.2
9	799.9	2.1	107.2	799.6	1.8	18.0	-18.0	0.9	2403.4
10	899.7	1.8	88.4	899.3	1.3	21.3	-21.3	0.7	2303.7
11	999.8	2.5	88.2	999.3	1.4	25.0	-25.0	0.6	2203.7
12	1098.8	3.3	94.5	1098.2	1.3	30.0	-30.0	0.9	2104.8
13	1199.4	3.1	102.0	1198.7	0.5	35.4	-35.4	0.5	2004.3
14	1299.2	3.3	90.7	1298.3	-0.1	40.9	-40.9	0.7	1904.7
15	1399.4	1.9	100.0	1398.4	-0.4	45.4	-45.4	1.4	1804.6
16	1499.7	1.6	131.6	1498.7	-1.7	48.1	-48.1	1.0	1704.3
17	1599.1	0.4	130.8	1598.0	-2.8	49.4	-49.4	1.2	1605.0
18	1699.8	0.2	241.4	1698.7	-3.2	49.6	-49.6	0.5	1504.3
19	1799.7	0.4	227.6	1798.6	-3.5	49.2	-49.2	0.2	1404.4
20	1899.9	0.4	15.6	1898.8	-3.4	49.0	-49.0	0.7	1304.2
21	1999.4	0.2	223.4	1998.3	-3.2	49.0	-49.0	0.6	1204.7
22	2099.9	0.0	207.6	2098.8	-3.4	48.8	-48.8	0.2	1104.2
23	2199.9	0.2	208.9	2198.8	-3.5	48.7	-48.7	0.1	1004.2
24	2271.3	0.9	177.9	2270.2	-4.2	48.7	-48.7	1.0	932.8
25	2304.0	2.9	264.0	2302.9	-4.5	47.9	-47.9	8.9	900.1
26	2335.0	8.2	275.3	2333.8	-4.4	44.9	-44.9	17.5	869.2
27	2365.0	14.0	277.8	2363.2	-3.7	39.2	-39.2	19.4	839.8
28	2397.0	20.4	277.4	2393.7	-2.4	29.8	-29.8	20.0	809.3
29	2429.0	25.0	276.0	2423.3	-1.0	17.6	-17.6	14.5	779.7
30	2460.0	29.8	277.0	2450.8	0.6	3.4	-3.4	15.6	752.2
31	2489.0	30.2	277.0	2475.9	2.4	-11.0	11.0	1.4	727.1
32	2521.0	33.6	276.0	2503.0	4.3	-27.8	27.8	10.8	700.0
33	2552.0	39.3	275.0	2528.0	6.0	-46.1	46.1	18.5	675.0
34	2583.0	44.9	273.0	2551.0	7.5	-66.8	66.8	18.6	652.0
35	2613.0	46.5	273.0	2571.9	8.6	-88.3	88.3	5.3	631.1
36	2645.0	46.6	273.0	2593.9	9.8	-111.5	111.5	0.3	609.1
37	2676.0	51.1	272.0	2614.3	10.8	-134.8	134.8	14.7	588.7
38	2707.0	57.0	270.0	2632.5	11.2	-159.9	159.9	19.7	570.5
39	2738.0	63.8	270.0	2647.8	11.2	-186.8	186.8	21.9	555.2
40	2770.0	69.8	270.0	2660.4	11.2	-216.2	216.2	18.8	542.6
41	2801.0	72.0	270.0	2670.6	11.2	-245.5	245.5	7.1	532.4
42	2833.0	72.2	270.0	2680.4	11.2	-276.0	276.0	0.6	522.6

					N - E	E - W			
43	2865.0	75.2	270.0	2689.4	11.2	-306.7	306.7	9.4	513.6
44	2896.0	81.6	270.0	2695.6	11.2	-337.0	337.0	20.6	507.4
45	2942.0	90.4	270.0	2698.8	11.2	-382.9	382.9	19.1	504.2
46	2974.0	91.2	270.0	2698.4	11.2	-414.9	414.9	2.5	504.6
47	3005.0	91.3	270.0	2697.7	11.2	-445.9	445.9	0.3	505.3
48	3037.0	91.5	270.0	2696.9	11.2	-477.8	477.8	0.6	506.1
49	3069.0	91.5	270.0	2696.1	11.2	-509.8	509.8	0.0	506.9
50	3100.0	91.5	270.0	2695.3	11.2	-540.8	540.8	0.0	507.7
51	3132.0	91.2	270.0	2694.5	11.2	-572.8	572.8	0.9	508.5
52	3164.0	90.8	270.0	2693.9	11.2	-604.8	604.8	1.3	509.1
53	3195.0	90.5	270.0	2693.6	11.2	-635.8	635.8	1.0	509.4
54	3227.0	90.8	270.0	2693.2	11.2	-667.8	667.8	0.9	509.8
55	3258.0	91.0	270.0	2692.7	11.2	-698.8	698.8	0.6	510.3
56	3290.0	91.0	270.0	2692.2	11.2	-730.8	730.8	0.0	510.8
57	3322.0	89.9	270.0	2691.9	11.2	-762.8	762.8	3.4	511.1
58	3354.0	90.2	270.0	2691.9	11.2	-794.8	794.8	0.9	511.1
59	3385.0	91.0	270.0	2691.6	11.2	-825.8	825.8	2.6	511.4
60	3417.0	90.7	270.0	2691.1	11.2	-857.8	857.8	0.9	511.9
61	3449.0	89.7	270.0	2691.0	11.2	-889.8	889.8	3.1	512.0
62	3481.0	89.6	270.0	2691.2	11.2	-921.8	921.8	0.3	511.8
63	3513.0	89.8	270.0	2691.4	11.2	-953.8	953.8	0.6	511.6
64	3544.0	89.2	270.0	2691.6	11.2	-984.8	984.8	1.9	511.4
65	3576.0	88.5	270.0	2692.3	11.2	-1016.8	1016.8	2.2	510.7
66	3608.0	88.1	270.0	2693.2	11.2	-1048.8	1048.8	1.3	509.8
67	3640.0	88.0	270.0	2694.3	11.2	-1080.7	1080.7	0.3	508.7
68	3672.0	87.9	270.0	2695.5	11.2	-1112.7	1112.7	0.3	507.5
69	3704.0	87.7	270.0	2696.7	11.2	-1144.7	1144.7	0.6	506.3
70	3736.0	87.1	270.0	2698.1	11.2	-1176.7	1176.7	1.9	504.9
71	3768.0	87.6	270.0	2699.6	11.2	-1208.6	1208.6	1.6	503.4
72	3800.0	87.5	270.0	2701.0	11.2	-1240.6	1240.6	0.3	502.0
73	3831.0	88.1	270.0	2702.2	11.2	-1271.6	1271.6	1.9	500.8
74	3863.0	88.5	270.0	2703.1	11.2	-1303.6	1303.6	1.3	499.9
75	3895.0	88.5	270.0	2704.0	11.2	-1335.6	1335.6	0.0	499.0
76	3927.0	89.6	270.0	2704.5	11.2	-1367.5	1367.5	3.4	498.5
77	3959.0	90.4	270.0	2704.5	11.2	-1399.5	1399.5	2.5	498.5
78	3991.0	91.4	270.0	2704.0	11.2	-1431.5	1431.5	3.1	499.0
79	4023.0	90.9	270.0	2703.3	11.2	-1463.5	1463.5	1.6	499.7
80	4054.0	90.8	270.0	2702.9	11.2	-1494.5	1494.5	0.3	500.1
81	4086.0	91.2	270.0	2702.3	11.2	-1526.5	1526.5	1.3	500.7
82	4117.0	91.6	270.0	2701.6	11.2	-1557.5	1557.5	1.3	501.4
83	4147.0	91.1	270.0	2700.9	11.2	-1587.5	1587.5	1.7	502.1
84	4179.0	90.5	270.0	2700.4	11.2	-1619.5	1619.5	1.9	502.6
85	4211.0	89.8	270.0	2700.3	11.2	-1651.5	1651.5	2.2	502.7
86	4238.0	89.3	270.0	2700.5	11.2	-1678.5	1678.5	1.9	502.5
87	4269.0	89.3	270.0	2700.9	11.2	-1709.5	1709.5	0.0	502.1
88	4301.0	90.1	270.0	2701.1	11.2	-1741.5	1741.5	2.5	501.9
89	4333.0	90.1	270.0	2701.0	11.2	-1773.5	1773.5	0.0	502.0
90	4364.0	90.6	270.0	2700.8	11.2	-1804.5	1804.5	1.6	502.2
91	4396.0	90.4	270.0	2700.6	11.2	-1836.5	1836.5	0.6	502.4
PRJ@TD	4438.0	90.4	270.0	2700.3	11.2	-1878.5	1878.5	0.0	502.7

RELEASED
MAY 18 1954

ION

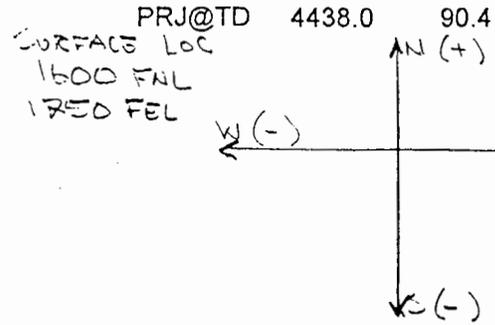

11.2 (+) NORTH 1600
-11.2
1750 FEL
1878.5 (-) WEST
KCC
FNL
APR 3
2128.5 FEL
CONFIDENTIAL
OK
CONFIDENTIAL
OK

RECEIVED
MAY 25 1954
