


Map No. Stevens 1 Sec. 32 Twp. 38 R. 38

Well No. Olson Farm

Argue Bros. Company

NORTH

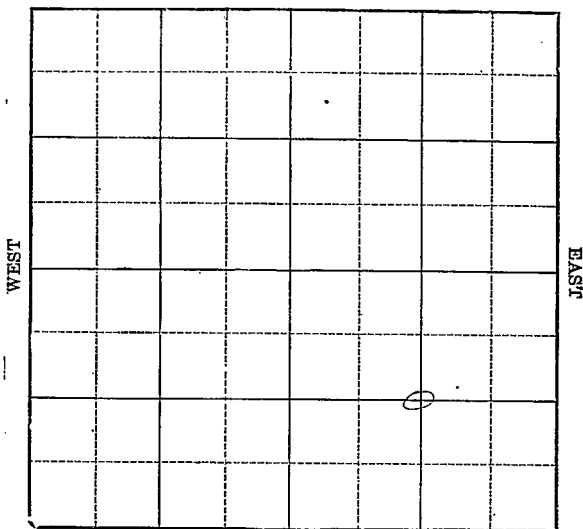

SOUTH

Location _____

Drilling Remarks _____

Rig Up _____

Drilling Remarks _____

RECORD

Cased _____ in. _____ ft.

Sand _____

Gas _____

Oil _____

Total Depth _____

PRODUCTION

1st 24 hrs. Nat. _____

1st 24 hrs. after shot _____

Gas _____ cu. ft.

Dry Hole _____

Abandoned _____

Map No. KANSAS Sec. 1 Twp. 32 R. 38^W

Well No. 17 Olsen Farm

Argus Gas Company

NORTH

WEST

EAST

SOUTH

 Ft. from N. Line

1320 Ft. from S. Line

1320 Ft. from E. Line

 Ft. from W. Line

1930

Date

REPORT

7/30	Loc
8/6	—
8/13	—
8/20	dry 80'
8/27	" 1920'
9/3	Rest 2470'
9/10	—
9/17	—
9/24	8"-2533 Rest
10/1	No report
10/8	Sand 2534-2725
	T.D. 2725
	13 At gas
	Corp.

Map No. KANSAS Sec. 1 Twp. 22 R. 38WWell No. 1 OlsenArgus Gas Company

Contractor

SECTION PLAT

_____ Ft. from N. Line

1320 Ft. from S. Line1320 Ft. from E. Line

_____ Ft. from W. Line

Location V

Rig up _____

Drilling and Remarks: _____

RECORD

Cased _____ in., _____ ft.

Sand _____

Gas _____

Oil _____

Total Depth _____

PRODUCTION

1st 24 hrs. Nat. _____

1st 24 hrs. after shot _____

Gas _____ Cu. Ft.

Dry Hole _____

Abandoned _____

Date

JUL 30 1930S. J. LEWIS Scout

Map No. **KANSAS** Sec. 1 Twp. 02 R. 08W

Well No. 1 Olson

Argus Gas Company

Contractor


SECTION PLAT

..... Ft. from N. Line

1820 Ft. from S. Line

1820 Ft. from E. Line

..... Ft. from W. Line

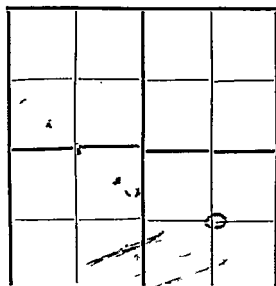

COMPLETED

Location.....

Rig up.....

Drilling and Remarks:

RECORD

Cased..... in., ft.

Sand 2534 - 2725

Gas 1341

Oil.....

Total Depth 2725

PRODUCTION

1st 24 hrs. Nat.....

1st 24 hrs. after shot.....

Gas..... Cu. Ft.

Dry Hole.....

Abandoned.....

Date

OCT 8 1930

S. J. LEWIS

Scout