
Stevens KANSAS

Form 51—5M—11-38—Palace

Section 4 Township 32 Range 38-W

Well No. #1 McClure

Company Panhandle Eastern

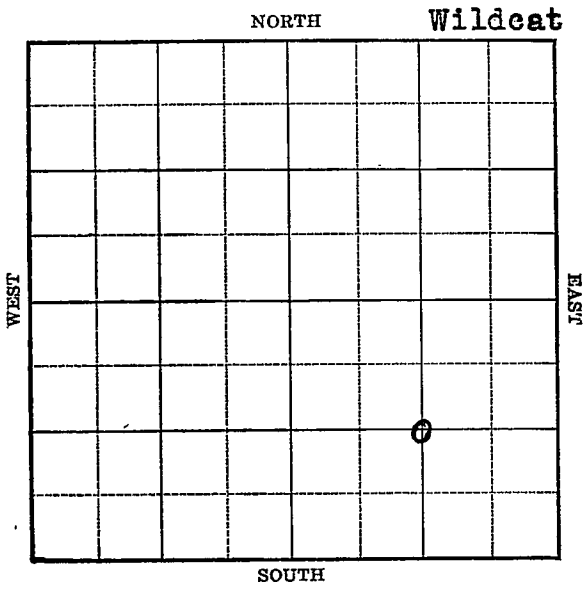

FORM 252-A 5M 4-39 KANSAS Stevens

Sec. 4 Twp. 32 R. 38W

Well No. #1 McClure Farm

Panhandle Eastern Company


(Wildcat)

_____ Ft. from N. Line

1320 Ft. from S. Line

1320 Ft. from E. Line

_____ Ft. from W. Line

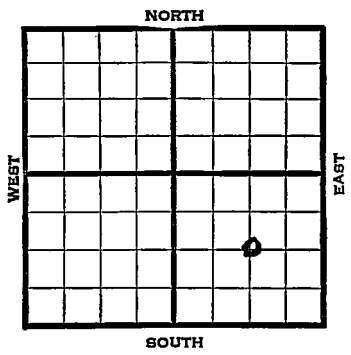

1939	REPORT
6/7	Location
6/16	"
6/23	"
6/29	Rotary.
7/6	"
7/13	Drlg. 550'
7/20	Drlg. 1825'
7/27	SD 1825' bad hole.
8/3	8" - 1366' Drlg. 1940'
8/10	5" - 2440' RUST.
8/17	Gas 2475' Drlg. 2530'
	3½ M gas.
8/23	Sand 2440'
	5" - 2440'
	T.D. 2715'
	P. B. to 2580'
	10,000 acid.
	18 M cu. ft. gas.
	COMPLETED

Form 26—1M Bks.—2-29 Stevens

KANSAS

Map No. NM Sec. 4 Twp. 32 R. 38W

Well No. 1 McClure

Panhandle Eastern Company

Contractor

FIRST REPORT

C SE

_____ Ft. from N. Line


1320 Ft. from S. Line

1320 Ft. from E. Line

_____ Ft. from W. Line

WILDCAT

SECTION PLAT

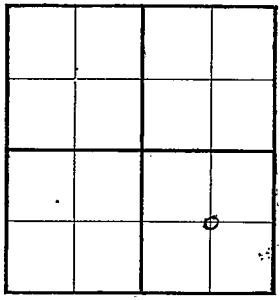

Location X

Rig up

Drilling and Remarks:

RECORD

Cased _____ in., _____ ft.

Sand

Gas

Oil

Total Depth

PRODUCTION

1st 24 hrs. Nat.

1st 24 hrs. after shot

Gas _____ Cu. Ft.

Dry Hole

Abandoned

Date

JUN 7 1939

19____

S. J. LEWIS Scout

Form 26—1M Bks.—2-25 KANSAS Stevens

Map No. NM Sec. 4 Twp. 32 R. 38W

Well No. 1 McCluse


Panhandle Eastern Company

Contractor

C S E

COMPLETED

SECTION PLAT

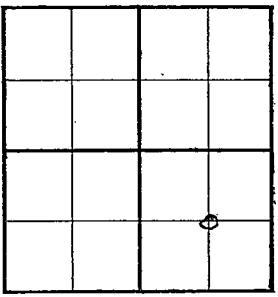

____ Ft. from N. Line

1320 Ft. from S. Line

1320 Ft. from E. Line

____ Ft. from W. Line

Wildcat

Location

Rig up

Drilling and Remarks:

Sand 2440

5" C 2440

P.B 2580

10000 acid

18 MM Gas

RECORD

Cased ____ in., ____ ft.

Sand

Gas

Oil

Total Depth 2715

PRODUCTION

1st 24 hrs. Nat.

1st 24 hrs. after shot

Gas ____ Cu. Ft.

Dry Hole

Abandoned

Date

AUG 23 1939 19____

S. J. LEWIS Scout