


Section 7 Township 32 Range 38 WWell No. # 1 YoungrenCompany Hugoton Prod.

NORTH

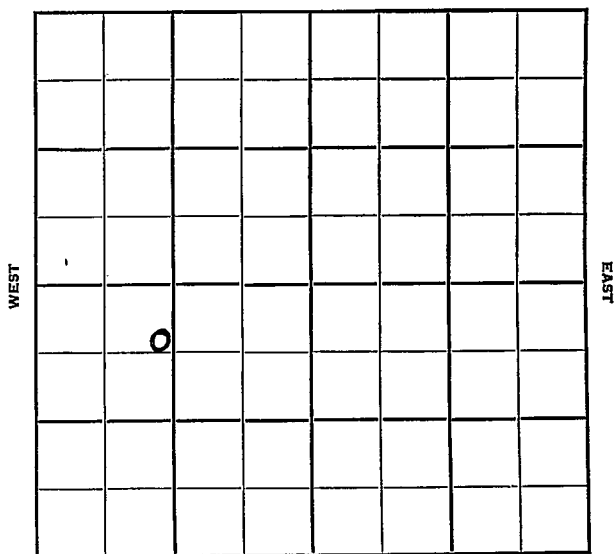

SOUTH

Stevens

KANSAS

Sec. 7 Twp. 32 R. 38 W

Well No. # 1 Youngren Farm

Hugoton Prod. Company

Contractor


 Ft. from N. Line

2053 Ft. from S. Line

 Ft. from E. Line

1253 Ft. from W. Line

NE NW SW

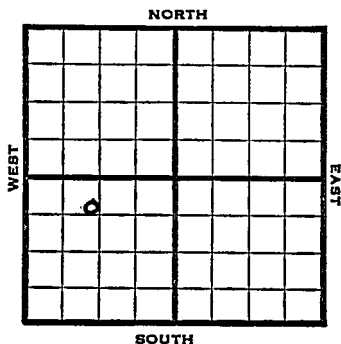

1952

Elev. 3175 REPORT

5/28

Location

6/11

10" @ 480' RTD 2419

7" @ 2406'

6/18

NR

6/25

TD 2661'

7/2

NR

7/9

"

7/17

NR

7/23

"

7/30

"

8/6

"

8/13

Hol 2374

Ker 2413

Krider 2427-96

Winfield 2507

Up Ft. 2570

Low Ft 2615

21,000 A

8/20

NR

8/27


"

9/4

Spud 6-3-52 Gas Well TD 2661
10" @ 480 7" @ 2406 TD 2661
Hol. 2374 Her. 2413 Kri 2427
Win. 2507 Ft. Riley 2570
21,000 A Comp. 36,926,000 gas

COMPLETED

County **Stevens** State **Kansas**
 Sec. **7** (Blk.) **32** (Sur.) **38W** Map No.
 Operator **Hugoton Prod.**
 Well No. **1** Farm **Youngren**
 Elev. Location **NE NW SW**

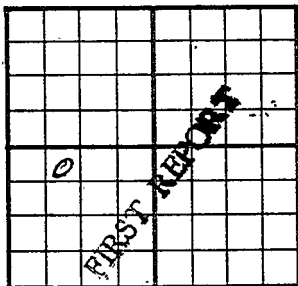

2053 Ft. From **S** Line **SW**

1253 Ft. From **N** Line Quarter

Ist. Report **MAY 28 1952**

Completion


Remarks

Spudding Date

Drlg. Data

Location

J. G. McGEHEE

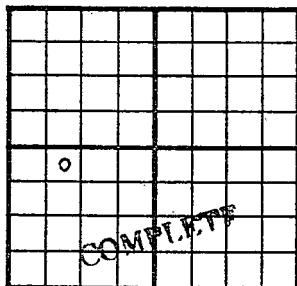County Stevens State KansasSec. 7 (Blk. Twp.) 32 (Sur. Rge.) 38W Map No.Operator Hugoton Prod.Well No. 1 Farm YoungrenElev. 3175 Location NE NW SW2053 Ft. From S Line SW1253 Ft. From W Line Quarter

1st. Report

Completion SEP 4 1952

Remarks

Spudding Date 6-3-52Drilg. Data Gas well TD 266110" @ 480 7" @ 2406 TD 2661Hol. 2374 Her. 2413 Kri. 2427Win. 2507 Ft. Riley 2570 21000 AComp. 36,926,000 gas

J. G. McGEHEE