Stevens


Form 51—5M—1-30—38840

Map No. KANSAS Sec. 21 Twp. 32 R. 38W

Well No. 1- WRD Lee Farm

Boston Rocky Dev Company

WESTERN PROD

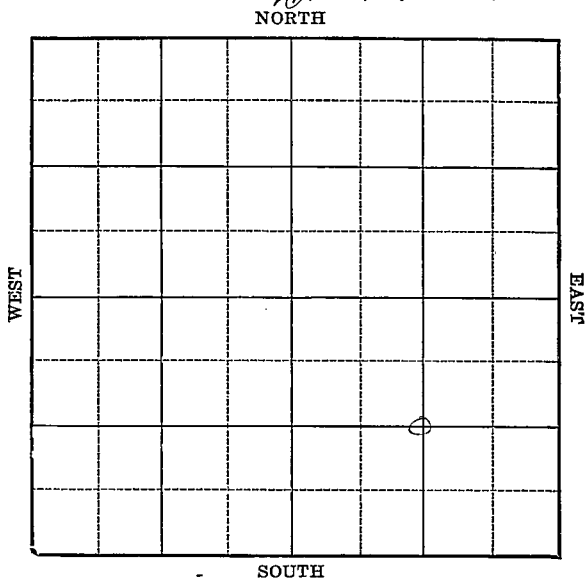

Location

Drilling Remarks

Rig Up

Drilling Remarks

RECORD

Cased ____ in. ____ ft.

Sand

Gas

Oil

Total Depth

PRODUCTION

1st 24 hrs. Nat.

1st 24 hrs. after shot

Gas ____ cu. ft.

Dry Hole

Abandoned

KANSAS
Form 252A—5M—11-29—38055

Stevens

Map No. _____ Sec. 21 Twp. ~~34~~ 32 R. 38 W

Well No. 1— W.R.D. FEE Farm


~~Western Royalty Dev.~~ Company
WESTERN PRODUCTION

_____ Ft. from N. Line

1320 Ft. from S. Line

1320 Ft. from E. Line

_____ Ft. from W. Line

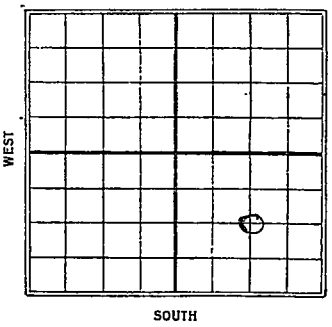

Date 1930	REPORT
8/27	Location
9/3	
9/10	Dirty 580'
9/17	" 2201'
9/24	" 2312'
10/1	No report
10/8	Rust 2515
	Dirty 2560
	Est. 12 M Gas
10/22	Sand 2560 - 2741
	T.D. 2741
	14 M Gas
	Comp.

Form 26—1M Bks.—2-29 Stevens

KANSAS

Map No. Sec. 21 Twp. 34 R. 38 W

Well No. 1 N. R. D. Fee

Western Royalty Dev Co Company

Contractor

FIRST REPORTS


Ft. from N. Line

1320 Ft. from S. Line

1320 Ft. from E. Line

Ft. from W. Line

SECTION PLAT

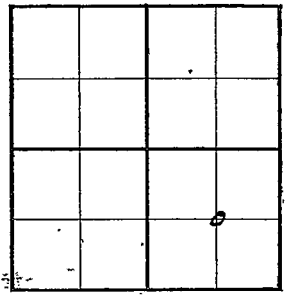

Location ✓

Rig up

Drilling and Remarks:

RECORD

Cased in., ft.

Sand

Gas

Oil

Total Depth

PRODUCTION

1st 24 hrs. Nat.

1st 24 hrs. after shot

Gas Cu. Ft.

Dry Hole

Abandoned

Date

AUG 27 1930 19

CHAS. L. SHERWOOD Scout

Form 20—1M Bks.—9-26

Texas


Map No. KANSAS Sec. 21 Twp. 32 R. 37 W

Well No. 1 W.R.D. Fee

Western Royalty Dev. Company

Contractor

SECTION PLAT

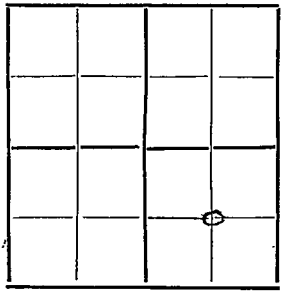

Ft. from N. Line

1320 Ft. from S. Line

1320 Ft. from E. Line

Ft. from W. Line

CORRECTION

Location

Rig up

Drilling and Remarks:

Repor Tec 6 21 34 37W

RECORD

Cased in., ft.

Sand

Gas

Oil

Total Depth

PRODUCTION

1st 24 hrs. Nat.

1st 24 hrs. after shot

Gas Cu. Ft.

Dry Hole

Abandoned

Date

SEP 10 1930

192

S. J. LEWIS Scout

Form 26—1M Blks.—9-28

Stevens


Map No KANSAS Sec. 21 Twp. 32 R. 38 W.

Well No. 1 W R II Fee

Western Production Company

Contractor

SECTION PLAT

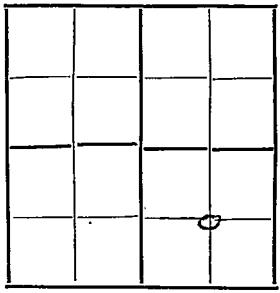

Ft. from N. Line

1320 Ft. from S. Line

1320 Ft. from E. Line

Ft. from W. Line

CORRECTION

Location

Rig up

Drilling and Remarks:

Reported
Western Royalty
Dev. Co.

RECORD

Cased in., ft.

Sand

Gas

Oil

Total Depth

PRODUCTION

1st 24 hrs. Nat.

1st 24 hrs. after shot

Gas Cu. Ft.

Dry Hole

Abandoned

Date

SEP 17 1930

192

S. J. LEWIS Scout

Form 26—4M-Bks. 9-28

Stevens


Map No. KANSAS Sec. 21 Twp. 32 R. 38W

Well No. 1 W R U Fee

Western Production Company

Contractor

SECTION PLAT

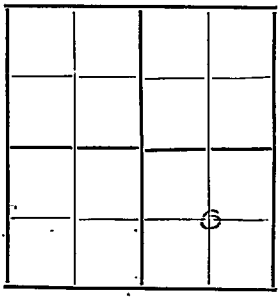

Ft. from N. Line

1320 Ft. from S. Line

1320 Ft. from E. Line

Ft. from W. Line

COMPLETED

Location

Rig up

Drilling and Remarks:

RECORD

Cased in., ft.

Sand 2560-2741

Gas 14M

Oil

Total Depth 2741

PRODUCTION

1st 24 hrs. Nat.

1st 24 hrs. after shot

Gas Cu. Ft.

Dry Hole

Abandoned

Date

OCT 2 2 1930 192

S. J. LEWIS Scout