


Stevens.
 Map No. KANSAS Sec. 31 Twp. 32 R. 38
 Well No. 1-J.V. Stevens Farm
Argus Gas Company

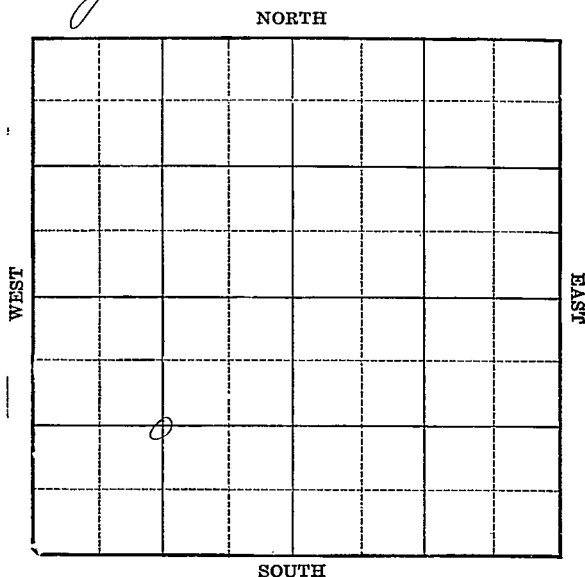

Location _____

Drilling Remarks _____

Rig Up _____

Drilling Remarks _____

RECORD

Cased _____ in. _____ ft.

Sand _____

Gas _____

Oil _____

Total Depth _____

PRODUCTION

1st 24 hrs. Nat. _____

1st 24 hrs. after shot _____

Gas _____ cu. ft.

Dry Hole _____

Abandoned _____

Map No. KANSAS Sec. 31 Twp. 32 R. 38^w
 Well No. 1- J.W. Davis Farm
Urges Gas Company

NORTH

_____ Ft. from N. Line

1320 Ft. from S. Line


_____ Ft. from E. Line

1320 Ft. from W. Line

1930

WEST

EAST

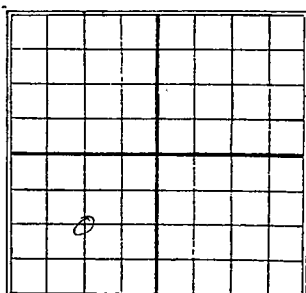

SOUTH

Date

REPORT

7/10	Loc
7/23	—
7/30	—
8/6	—
8/13	Rign up.
8/20	—
8/27	12" - 630 Wdg 1350
9/3	Rust 2365'
9/10	Rust 2439'
9/17	—
9/24	—
10/1	No report
10/8	Sand 2439-2675 T.D. 2675 8 M gas Comp

Stevens
Map No. **KANSAS** Sec. *31* Twp. *32* R. *38W*

Well No. *12 H Davis**Cirrus Gas* Company


Contractor

SECTION PLAT

Ft. from N. Line

1320 Ft. from S. Line

Ft. from E. Line

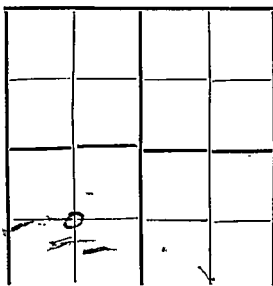1320 Ft. from W. Line

COMPLETED

Location.....

Rig up.....

Drilling and Remarks:

RECORD

Cased.....in., ...ft.

Sand *2439-2675*Gas *SM*

Oil.....

Total Depth *2675*

PRODUCTION

1st 24 hrs. Nat.....

1st 24 hrs. after shot.....

Gas.....Cu. Ft.

Dry Hole.....

Abandoned.....

Date

*OCT 8 1930**S. J. LEWIS*

Scout

Map No. KANSAS Sec. 31 Twp. 32 R. 38WWell No. J. J. DavisCrown Gas CompanyJ. J. Davis Contractor

SECTION PLAT

_____ Ft. from N. Line

1320 Ft. from S. Line

_____ Ft. from E. Line

1320 Ft. from W. Line

FIRST REPORTS

Location ✓

Rig up _____

Drilling and Remarks:

RECORD

Cased _____ in., _____ ft.

Sand _____

Gas _____

Oil _____

Total Depth _____

PRODUCTION

1st 24 hrs. Nat. _____

1st 24 hrs. after shot _____

Gas _____ Cu. Ft.

Dry Hole _____

Abandoned _____

Date

JUL 16 1930S. J. LEWIS Scout