

KANSAS


Stevens County

FORM 51 5M PETROL

Section 28 Township 32 Range 38W

Well No. 1 Helgeson

Company Pan Handle Eastern

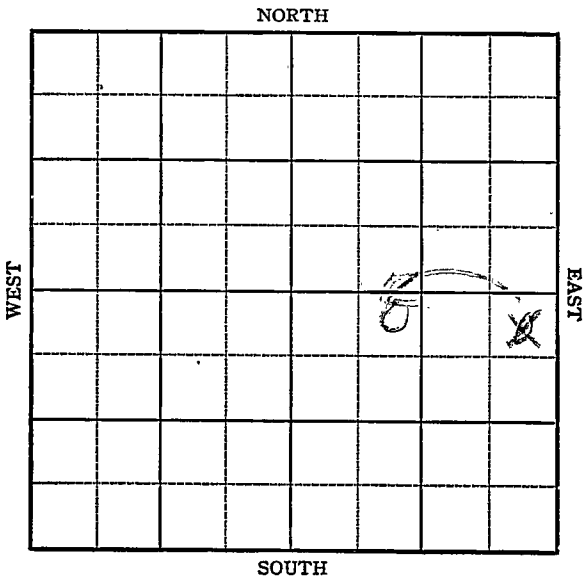

KANSAS

Stevens

Sec. 28 Twp. 32 R. 38TH

Well No. 1 Helgeson Farm

Pan Handle Eastern Company

Hugoton


150 Ft. from N. Line

Ft. from S. Line

150 Ft. from E. Line

1150 Ft. from W. Line

NE ~~NE~~ SE Elev. 3186

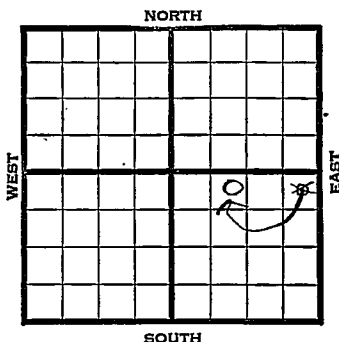

1945	REPORT
5/16	Location
5/24	10" @ 569
	Drlg. 1140
5/31	1581 Lost circulation
6/8	12" @ 1200 TD 1585
6/14	13" @ 532
6/21	7" @ 2508
	TD 2515 RUST
6/28	TD 2574
	1 1/2 W Gas
7/3	268' of 5" perf. liner @ 2574
7/11	" " " " " "
7/19	" " " " " "
7/26	" " " " " W
8/1	" " " " " "
8/8	" " " " " "
8/15	" " " " " "
8/22	" " " " " "
8/29	" " " " " "
9/5	" " " " " "
9/12	" " " " " "
9/19	" " " " " "
9/26	" " " " " "
10/3	" " " " " "
10/10	" " " " " "
10/17	M " " " " " "
10/24	" " " " " "
10/31	" " " " " "
11/7	" " " " " "
	OVER

1945

11/14	268'	5"	perf. liner @ 2574'
11/21	"	"	"
11/28	"	"	"
12/5	"	"	"
12/12	"	"	"
12/20	"	"	"
12/28	7"	@ 2508	
	268'	of 5" Perf. liner @ 2763	
	12,500	acid.	
	TD 2763		
	13,779,000	Gas.	
	372#	R Pr.	

COMPLETED

Kansas Pool Name Hugoton

Map No. no map Sec. 28 Twp. 32 R. 38W

Well No. 1 Helgeson

Pan Handle Eastern Company

FIRST REPORT

NE SE Contractor


150 Ft. from N. Line

 Ft. from S. Line

150 Ft. from E. Line

 Ft. from W. Line

SECTION PLAT

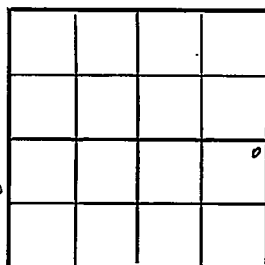

Stevens

Location X

Rig up

Drilling and Remarks:

RECORD

Cased in., ft.

Sand

Gas

Oil

Total Depth

PRODUCTION

1st 24 hrs. Nat.

1st 24 hrs. after shot

Gas Cu. Ft.

Dry Hole

Abandoned

Date

MAY 16 1945 19 S. J. LEWIS Scout

Kansas Pool Name HugotonMap No. _____ Sec. 28 Twp. 32 R. 38WWell No. 1 HelgesonPanhandle Eastern Company**CORRECTION** Contractor _____


NE NW SE

SECTION PLAT

150 Ft. from N. Line

_____ Ft. from S. Line

_____ Ft. from E. Line

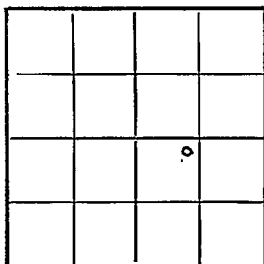1150 Ft. from W. Line

Stevens County

Location _____

Rig up _____

Drilling and Remarks:
reported NE SE

RECORD

Cased _____ in., _____ ft.

Sand _____

Gas _____

Oil _____

Total Depth _____

PRODUCTION

1st 24 hrs. Nat. _____

1st 24 hrs. after shot _____

Gas _____ Cu. Ft.

Dry Hole _____

Abandoned _____

Date

JUN 20 1945

19

S. J. LEWIS

Scout

KANSAS

Kansas

Pool Name HugotonMap No. 10 map B Sec. 28 Twp. 32 R. 38WWell No. 1 HelgesonPanhandle Eastern Company**COMPLETED**

Contractor

NE NW SE

E 1/3 170
SECTION PLAT150 Ft. from N. Line Ft. from S. Line Ft. from E. Line1150 Ft. from W. Line

		0	

Stevens CountyLocation Rig up

Drilling and Remarks:

7" C2508.268' of 5" Pay lineC2763 112,500 acid18,779,000 Gas372th R/R**RECORD**Cased in., ft.Sand Gas Oil Total Depth 2763**PRODUCTION**1st 24 hrs. Nat. 1st 24 hrs. after shot Gas Cu. Ft.Dry Hole Abandoned

Date

DEC 2 8 1945 19S. J. LEWIS

Scout