


Well No. 1-1 Gustafson Farm

Wabco Gas Company

NORTH

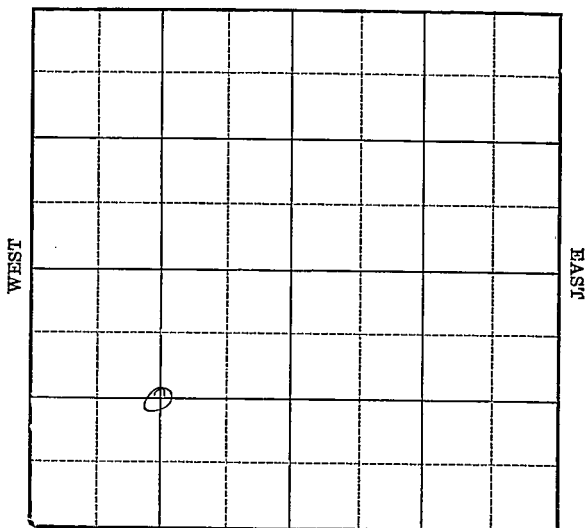

SOUTH

Location_____

Drilling Remarks

Rig Up

Drilling Remarks

RECORD

Cased _____ in. _____ ft.

Sand_____

Gas_____

Oil_____

Total Depth_____

PRODUCTION

1st 24 hrs. Nat.-----

1st 24 hrs. after shot_____

Gas_____cu. ft._____

Dry Hole_____

Abandoned_____

Map No. KANSAS Sec. 29 Twp. 32 R. 38^w
 Well No. 1- Gustafson Farm
Argus Gas Company


_____ Ft. from N. Line

1320 Ft. from S. Line

_____ Ft. from E. Line

1320 Ft. from W. Line

1930

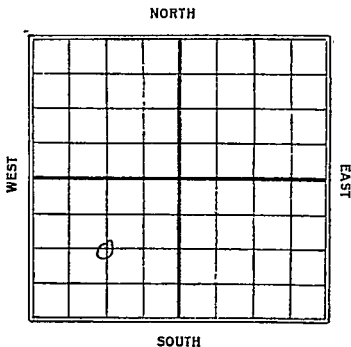

Date

REPORT

4/23

Loc.

4/30

Bad titles

Abandon loc.

Map No. KANSAS Sec. 29 Twp. 22 R. 21WWell No. 1 GustafsonArgus Gas Company

Contractor

SECTION PLAT


Ft. from N. Line

1820 Ft. from S. Line

Ft. from E. Line

1820 Ft. from W. Line

ABANDONED

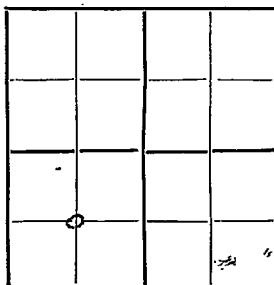Location ✓

Rig up

Drilling and Remarks:

Bad Titles

RECORD

Cased _____ in., _____ ft.

Sand _____

Gas _____

Oil _____

Total Depth _____

PRODUCTION

1st 24 hrs. Nat. _____

1st 24 hrs. after shot _____

Gas _____ Cu. Ft.

Dry Hole _____

Abandoned _____

Date

APR 30 1930

192

S. J. LEWIS Scout

Map No. 29 KANSAS Sec. 29 Twp. 22 R. 28WWell No. 1 GustafsonRegus Gas. Company


Contractor

SECTION PLAT

Ft. from N. Line

1320 Ft. from S. Line

Ft. from E. Line

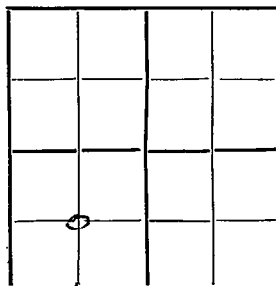1320 Ft. from W. Line

FIRST REPORTS

Location ✓Rig up ✓

Drilling and Remarks:

RECORD

Cased in., ft.Sand Gas Oil Total Depth

PRODUCTION

1st 24 hrs. Nat. 1st 24 hrs. after shot Gas Cu. Ft.Dry Hole Abandoned

Date

 192 S. J. LEWIS Scout