


Map No. 34 KANSAS Sec. 32 Twp. 38 R. 38

Well No. 1-R.W. Crawford Farm
Missouri & Kansas Oil Company

NORTH

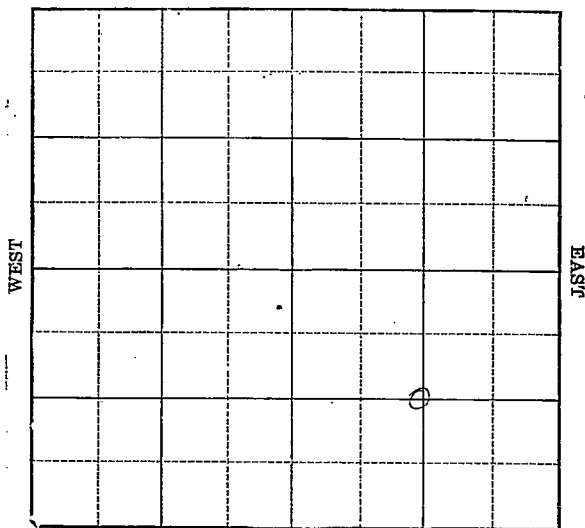

SOUTH

Location _____

Drilling Remarks _____

Rig Up _____

Drilling Remarks _____

RECORD

Cased _____ in. _____ ft.

Sand _____

Gas _____

Oil _____

Total Depth _____

PRODUCTION

1st 24 hrs. Nat. _____

1st 24 hrs. after shot _____

Gas _____ cu. ft.


Dry Hole _____

Abandoned _____

Map No. KANSAS Sec. 34 Twp. 32 R. 38^W

Well No. 1-R.W. Crawford Farm
Missouri & Kansas P.L. Co. Company

NORTH

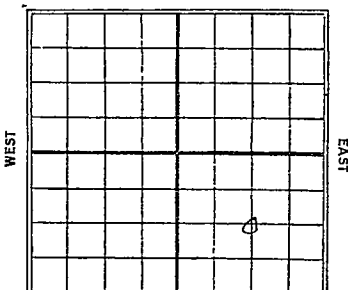

Ft. from N. Line

1320 Ft. from S. Line

1320 Ft. from E. Line

Ft. from W. Line

1030

Date

REPORT

7/23	Loc
7/30	
8/6	Rign up
8/13	
8/20	dry 1370'
8/27	" 1440'
9/3	Log pipe 1440'
9/10	dry 1620'
9/17	SD 1712'
9/24	dry 2096'
10/1	No report
10/8	Rust 2458
	dry 2650'
10/22	Sand 2510-2795
	T.D. 2795
	2 3/4 M Gas
	Comp.

Stevens
 Map No. **KANSAS** Sec. 34 Twp. 32 R. 38W

Well No. 1 R. W. Crawford
Missouri & Kansas *Pipe Line* Company

Contractor

SECTION PLAT

_____ Ft. from N. Line

1320 Ft. from S. Line

1320 Ft. from E. Line

_____ Ft. from W. Line

FIRST REPORTS

Location ✓

Rig up _____

Drilling and Remarks:

RECORD

Cased _____ in., _____ ft.

Sand _____

Gas _____

Oil _____

Total Depth _____

PRODUCTION

1st 24 hrs. Nat. _____

1st 24 hrs. after shot _____

Gas _____ Cu. Ft.

Dry Hole _____

Abandoned _____

Date

JUL 23 1930

S. J. LEWIS Scout


Map No. KANSAS Sec. 34 Twp. 32 R. 38W

Well No. 1 R W Crawford

Missouri & Kansas Pipe Line Company

Contractor

SECTION PLAT

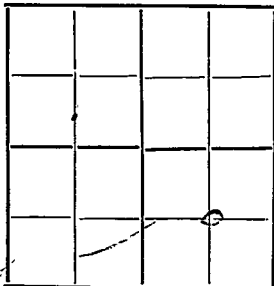

Ft. from N. Line

1820 Ft. from S. Line

1820 Ft. from E. Line

Ft. from W. Line

COMPLETED

Location

Rig up

Drilling and Remarks:

RECORD

Cased _____ in., _____ ft.

Sand 2510' - 2795'

Gas 2 3/4 M

Oil _____

Total Depth 2795'

PRODUCTION

1st 24 hrs. Nat. _____

1st 24 hrs. after shot _____

Gas _____ Cu. Ft.

Dry Hole _____

Abandoned _____

Date

OCT 22 1930 S. J. LEWIS Scout