

Section 17 Township 32 Range 39WWell No. #1 LautaretCompany Cities Service

NORTH

				0			

WEST

EAST

SOUTH

Morton

KANSAS

Sec. 17 Twp. 32 R. 39W

Well No. #1 Lautaret Farm

Cities Service Company

Contractor


100' Ft. from N. Line

Ft. from S. Line

Ft. from E. Line

225' Ft. from W. Line

NW SE

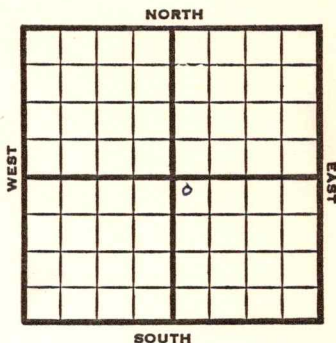

1951

Elev. 3270'

REPORT

6/13 8" @ 538'

8/8 Spud 6-11-51
Gas well TD 2650' 8" @ 538'
5" @ 2649' TD 2650'
110/2606-28 100/2558-78'
20/2548-52 30/2534-40
50/2496-2506 50/2486-92
30/2472-78 120/2430-54
20/2414-18 20/2406-10

Krider 2402-18' Win. 2473-2515'

Ft. Riley 2546' 31,000 A

Comp. 18,800,000 gas 403#

COMPLETED

County **Morton** State **Kansas**

Sec. 17 (Blk.) 32 (Sur.) 39W Map No.

Operator Cities Service

Well No. 1 Farm Lauteret

Elev.	Location	NW	SE
-------	----------	----	----

FIRST REPORT

100 Ft. From N Line SE

225 Ft. From **W** Line Quarter

1st. Report JUN 13 1951

Completion

Remarks


Spudding Date _____

Drlg. Data

8th @ 538

8. E TYRA

County Morton State Kansas
 Sec. 17 (Blk.) 32 (Sur.) 39W Map No.
 Operator Cities Service
 Well No. 1 Farm Lautaret
 Elev. 3270 Location NW SE

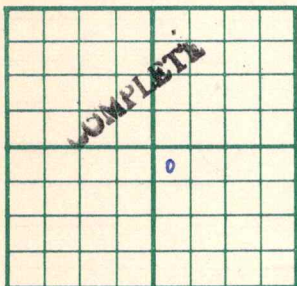

100 Ft. From N Line SE
225 Ft. From W Line Quarter

1st. Report

Completion AUG 8 1951

Remarks

Spudding Date 6-11-51

Drlg. Data Gas well TD 2650

8" @ 538 5" @ 2649 TD 2650

110/ 2606-28 100/ 2558-78 20/ 2548-52

30/ 2534-40 50/ 2496-2506 50/ 2486-92

30/ 2472-78 120/ 2430-54 20/ 2414-18

20/ 2406-10 Krider 2402-18 Win. 2473-

2515 Ft. Riley 2546 31000 A

Comp. 18,800,000 gas 403#