


Section 18 Township 32 Range 39 W

Well No. # 1 Crayton "A"

Company Cities Service

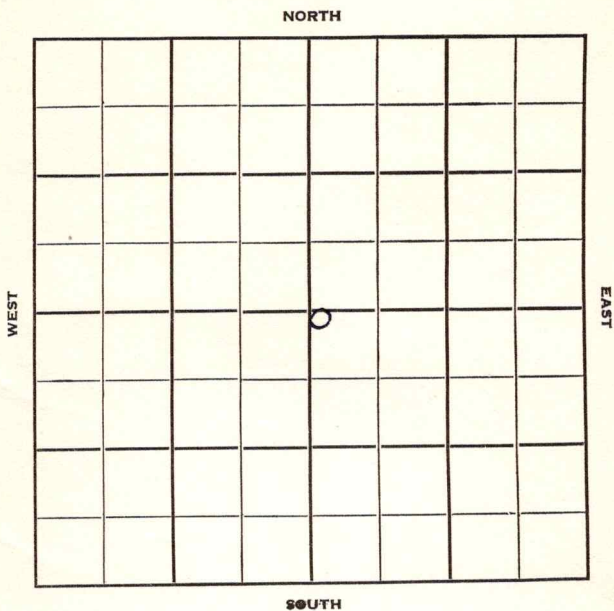

Sec. 18 Twp. 32 R. 39 W

Well No. # 1 Crayton "A" Farm

Cities Service Company

Contractor

Hugoton Pool


100 Ft. from N. Line

Ft. from S. Line

Ft. from E. Line

100 Ft. from W. Line

NW SE

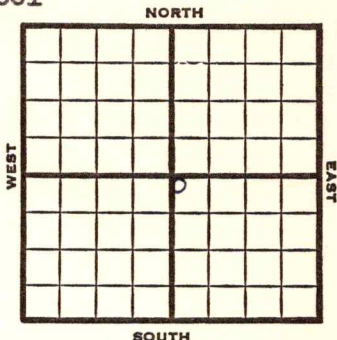

1951

Elev. 3286 REPORT

5/29

Location

7/18

Spud 6-4-51

Gas Well TD 2645

8" @ 587 5" @ 2644

TD 2645 Her. 2374

Krider 2402 Win 2462

Ft. Riley 2534

CO to 2621 110/2596-2618

90/2548-66 80/2524-40

30/2490-96 30/2476-82

40/2462-70 80/2426-42

40/2414-22 30/2402-08

30,500 A

Comp. 20,700,000 gas 403#

COMPLETED

County Morton State Kansas

Sec. 18 (Blk. Twp.) 32 (Sur. Rge.) 39W Map No.

Operator Cities Service

Well No. 1 Farm Crayton "A"

Elev. _____ Location NW SE

100 Ft. From N Line SE

100 Ft. From W Line Quarter

1st. Report MAY 29 1951

Completion _____

Remarks _____

Spudding Date _____

Drlg. Data Hugoton Pool

Location

J. E. TYRA

County Morton State Kansas

Sec. 18 (Blk. Twp.) 32 (Sur. Rge.) 39W Map No.

Operator Cities Service

Well No. 1 Farm Crayton "A"

Elev. 3286 Location NW SE

100 Ft. From N Line SE

100 Ft. From W Line Quarter

1st. Report

Completion JUL 18 1951

Remarks Hugoton Pool

Spudding Date 6-4-51

Drlg. Data Gas well TD 2645

8" @ 587 5" @ 2644 TD 2645

Her. 2374 Krider 2402 Win. 2462

Ft. Riley 2534 CO to 2621 110/ 2596-261

2618 90/ 2548-66 80/ 2524-40 30/ 2490-

96 30/ 2476-82 40/ 2462-70 80/ 2426-42

40/ 2414-22 30/ 2402-08 30500 A

Comp. 20,700,000 gas 403#