


Company Stanolind

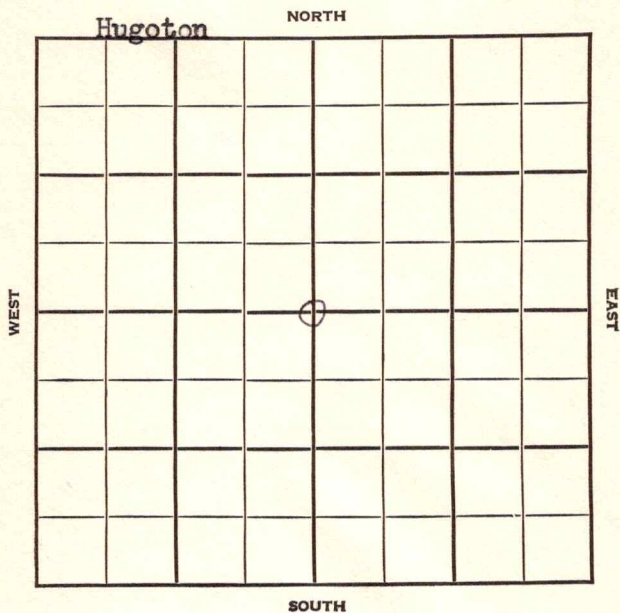

KANSAS.

Morton

Sec. 19 Twp. 32 R. 39W

Well No. #1 Tillet Farm
Stanolind Company

Hugoton Pool


2640' Ft. from N. Line

 Ft. from S. Line

2640' Ft. from E. Line

 Ft. from W. Line

C. Sec.

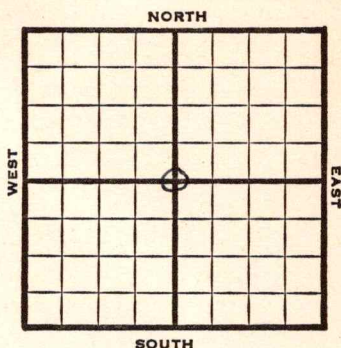

1948

Elev. 3252' REPORT

3/3 Location

3/10 "

3/17 "

3/24 "

3/31 "

4/7 RUR

4/14 10" @ 646'
Drlg. 2410'

4/21 TD 2420'
7" @ 2389'

4/28 RUST
TD 2605'
230' of 5" perf. liner @ 2605'
17,500 acid.

5/5 "

5/12 7" @ 2389'
230' of 5" perf. liner @ 2605'
17,500 acid.
12,896,000 gas
408# R. Pr.
TD 2605'
Comp.

COMPLETED

Map No. _____ Sec. 19 Twp. 32 R. 39W

Well No. 1 Tillet

Stanolind Company

1937 Contractor

C Sec.


SECTION PLAT

2640 Ft. from N. Line

_____ Ft. from S. Line

2640 Ft. from E. Line

_____ Ft. from W. Line

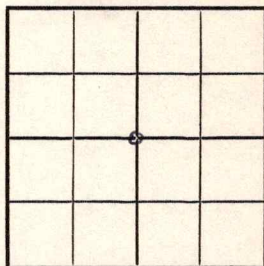

Morton County

Location X

Rig up _____

Drilling and Remarks:

RECORD

Cased _____ in., _____ ft.

Sand _____

Gas _____

Oil _____

Total Depth _____

PRODUCTION

1st 24 hrs. Nat. _____

1st 24 hrs. after shot _____

Gas _____ Cu. Ft.

Dry Hole _____

Abandoned _____

Date

MAR 3 1948 19 S. J. LEWIS Scout

Map No. _____ Sec. 19 Twp. 32 R. 39W

Well No. 1 Tillet

Stanolind Company

COMPLETE

Contractor

C Sec.


E1322
SECTION PLAT

2640 Ft. from N. Line

_____ Ft. from S. Line

2640 Ft. from E. Line

_____ Ft. from W. Line

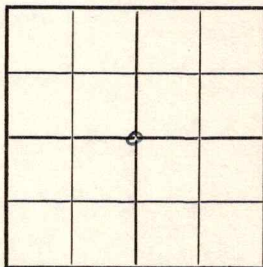

Morton County

Location _____

Rig up _____

Drilling and Remarks:

7' 02389
280' x 5" Refractive
02605
17500 acid
12,896,000 Gas
408# R2

RECORD

Cased _____ in., _____ ft.

Sand _____

Gas _____

Oil _____

Total Depth 2605

PRODUCTION

1st 24 hrs. Nat. _____

1st 24 hrs. after shot _____

Gas _____ Cu. Ft.

Dry Hole _____

Abandoned _____

Date

MAY 12 1948

S. J. LEWIS Scout