FORM 51 25M 8-50 WESTERN Morton KANSAS

Section 21 Township ~~31~~ 32 Range 39W

Well No. 1 Renshaw

Company Stanolind

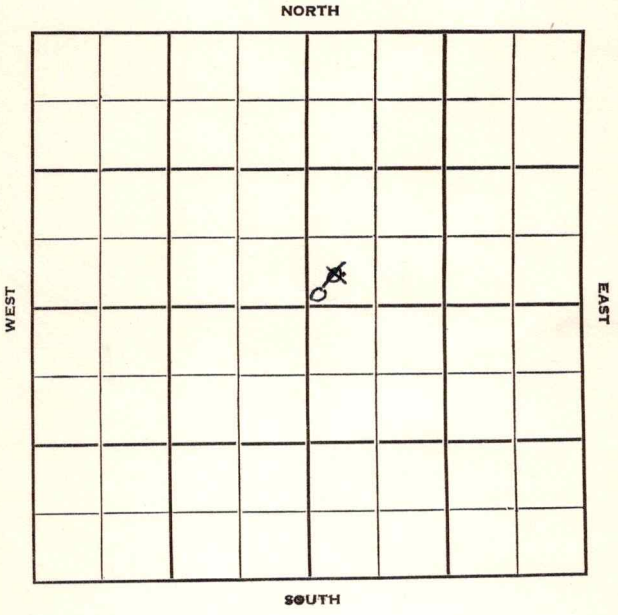

FORM 252-B
10M 11-50 PETROL

Morton KANSAS

Sec. 21 Twp. ~~31~~ 32 R. 39W

Well No. #1 Renshaw Farm

Stanolind Company

Contractor

Ft. from N. Line

150' Ft. from S. Line

Ft. from E. Line

150' Ft. from W. Line

SW SW NE

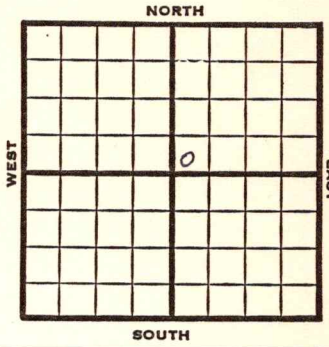

1951	Elev. 3238' REPORT
7/18	Spud 7-14-51 10" @ 610 Drlg. 620'
8/29	Spud 7-14-51 Gas well TD 2662' 10" @ 610 Her 2444' Win 2525' Ft. Riley 2580' TD 2628' 5" @ 2623' DD 2662' 42/2453-60 54/2467-76 48/2478-86 24/2523-31 18/2541-44 48/2554-62 24/2566-70 24/2592-98 84/2602-16 19000 A Comp. 9,610,000 gas 330#

COMPLETED

FORM 275 FOR SALE BY KANSAS BLUE PRINT CO.

County Morton State Kansas

Sec. 21 (Blk. Twp.) 31 (Sur. Rge.) 39W Map No.

Operator Stanolind

Well No. 1 Farm Renshaw

Elev. Location SW SW NE

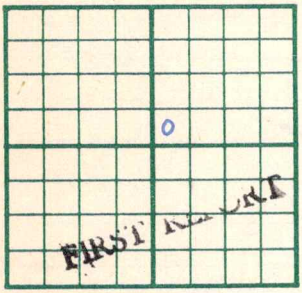

150 Ft. From S Line NE

150 Ft. From W Line Quarter

1st. Report JUL 1 8 1951

Completion

Remarks

Spudding Date 7-14-51

Drlg. Data

10" @ 610 drlg. 620

J. E. TYRA

Form 26 200 Bks. 11-49 Petrol

Kansas

Map No. _____ Sec. 21 Twp. 32 R. 39W

Well No. 1 Renshaw

Stanolind Company

CORRECTION Contractor

SW SW NE

SECTION PLAT

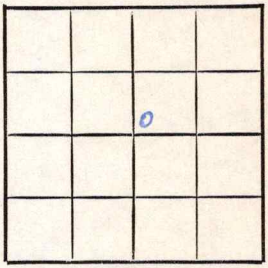

_____ Ft. from N. Line

150 Ft. from S. Line

_____ Ft. from E. Line

150 Ft. from W. Line

Morton County

Location _____

Rig up _____

Drilling and Remarks:

Reported
21-31-39W

RECORD

Cased _____ in., _____ ft.

Sand _____

Gas _____

Oil _____

Total Depth _____

PRODUCTION

1st 24 hrs. Nat. _____

1st 24 hrs. after shot _____

Gas _____ Cu. Ft.

Dry Hole _____

Abandoned _____

Date

AUG 1 1951 19 J. E. TYRA Scout

FORM 275 FOR SALE BY KANSAS BLUE PRINT CO.

County Morton State Kansas

Sec. 21 (Blk. / Twp.) 32 (Sur. / Rge.) 39W Map No.

Operator Stanolind

Well No. 1 Farm Renshaw

Elev. 3238 Location SW SW NE

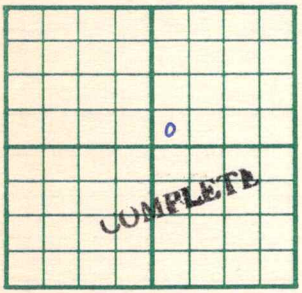

150 Ft. From S Line NE

150 Ft. From W Line Quarter

1st. Report

Completion AUG 29 1951

Remarks

Spudding Date 7-14-51

Drlg. Data Gas well TD 2662

10" @ 610 Her. 2444 Win. 2525

Ft. Riley 2580 TD 2628 5" @ 2623

DD 2662 42/ 2453-60 54/ 2467-76

48/ 2478-86 24/ 2523-31 18/ 2541-44

48/ 2554-62 24/ 2566-70 24/ 2592-98

84/ 2602-16 19000 A Comp. 9,610,000 gas

330#

J. E. TYRA