


Stevens

KANSAS

Section 25 Township ~~33~~ 32 Range 39-W

Well No. 1 Armstrong

Company Panhandle Eastern

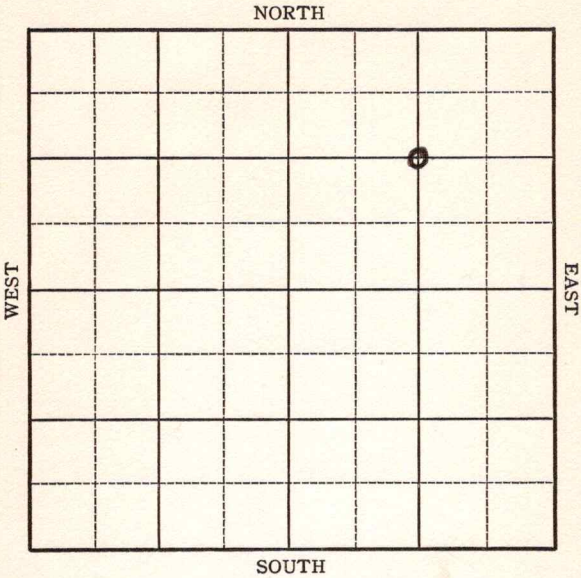


KANSAS

Stevens

Sec. 25 Twp. ~~33~~ 32 R. 39-WWell No. #1 Armstrong FarmPanhandle Eastern Company1320 Ft. from N. Line Ft. from S. Line1320 Ft. from E. Line Ft. from W. Line

Elev. 3210'.

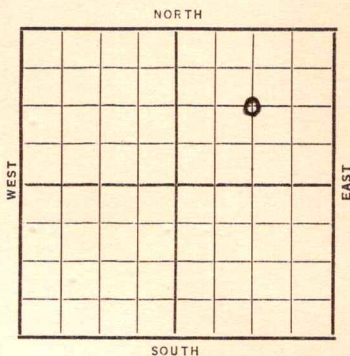

Date

REPORT

1937

12/1

R U R

12/10

"

12/17

Drl g. 300'.

12/24

10" @ 595'. Drl g. 2150'.

12/31

"

"

"

"

"

1938

1/7

T.D. 2270' Fsg.

1/14

"

"

"

1/20

"

"

"

1/28

"

"

"

2/4

"

"

"

2/11

Drl g. 2400'.

2/18

7" @ 2455'. RUST.

2/26

T.D. 2640'. C.O.

3/4

"

"

"

OVER

1938

3/9 7" @ 2455'.

Sand ?

T.D. 2753'.

13 M gas.

COMPLETED

Stevens **KANSAS**Map No. _____ Sec. 25 Twp. 33 R. 39WWell No. 1 ArmstrongPanhandle Eastern Company

Contractor _____

FIRST REPORT**C. NE**1320 Ft. from N. Line

_____ Ft. from S. Line

1320 Ft. from E. Line

_____ Ft. from W. Line

SECTION PLAT

		⊙	

Location _____

Rig up _____

Drilling and Remarks:

RUR**RECORD**

Cased _____ in., _____ ft.

Sand _____

Gas _____

Oil _____

Total Depth _____

PRODUCTION

1st 24 hrs. Nat. _____

1st 24 hrs. after shot _____

Gas _____ Cu. Ft.

Dry Hole _____

Abandoned _____

Date

DEC 1 - 1937 19H. D. Hatfield

Scout

Map No. NM Sec. 25 Twp. 32 R. 39WWell No. 1- ArmstrongPanhandle Eastern Company

Contractor

CNE

SECTION PLAT

1320 Ft. from N. Line

_____ Ft. from S. Line

1320 Ft. from E. Line

_____ Ft. from W. Line

Location _____

RECORD

Cased _____ in., _____ ft.

Sand _____

Gas _____

Oil _____

Total Depth _____

PRODUCTION

1st 24 hrs. Nat. _____

1st 24 hrs. after shot _____

Gas _____ Cu. Ft.

Dry Hole _____

Abandoned _____

Date

DEC 22 1887 19

H. D. Hatfield

Scout

KANSAS

Stevens

Map No. NM Sec. 25 Twp. 32 R. 39WWell No. 1 ArmstrongPanhandle Eastern

Company

Contractor

COMPLETED

SECTION PLAT

C NE

1320 Ft. from N. Line

Ft. from S. Line

1320 Ft. from E. Line

Ft. from W. Line

Location _____

RECORD

Cased 7 in., 2455 ft.Sand ?

Gas _____

Oil _____

Total Depth 2753

PRODUCTION

1st 24 hrs. Nat. _____

1st 24 hrs. after shot _____

Gas _____ Cu. Ft.

Dry Hole _____

Abandoned _____

Date

MAR 9 - 1938

19

H. D. Hatfield

Scout