FORM 51 25M 3-49 PETROL


KANSAS

Stevens

Section 22 Township 32 Range 39-W

Well No. #1-22 Jenkins

Company Panhandle Eastern

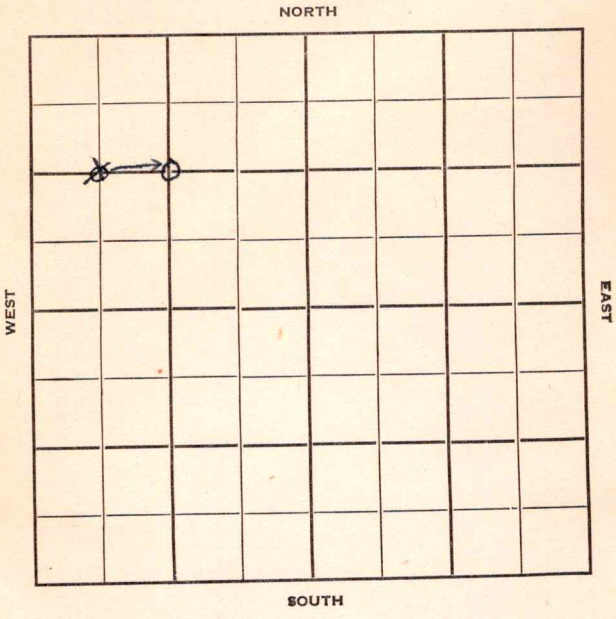

FORM 252-B
10M 9-49 PETROL

KANSAS

Stevens

Sec. 22 Twp. 32 R. 39W

Well No. #1-22 Jenkins Farm

Panhandle Eastern Company

Contractor

Hugoton Pool


1320' Ft. from N. Line

Ft. from S. Line

Ft. from E. Line

1318' Ft. from W. Line

C NW/4

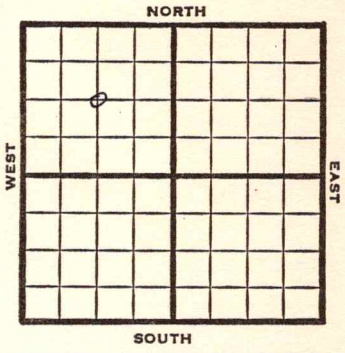

1950 Elev 3219 REPORT

6/28 Location
8/30 10" @ 557
7" @ 2394
TD 2404
Hol 2360 Her 2398
Krider 2422 Win 2498
Ft. Riley 2569
TD 2608
Comp 5,670,000 gas
Completed

COMPLETED

Form 26 200 Bks. 11-49 Petrol

Kansas

Hugoton Pool

Map No. _____ Sec. 22 Twp. 32 R. 39W

Well No. 1-22 Jenkins

Panhandle Eastern Company

Contractor

C NW/4

1320 Ft. from N. Line

_____ Ft. from S. Line

_____ Ft. from E. Line

1318 Ft. from W. Line

SECTION PLAT



Stevens County

Location x

Rig up _____

Drilling and Remarks:

RECORD

Cased _____ in., _____ ft.

Sand _____

Gas _____

Oil _____

Total Depth _____

PRODUCTION

1st 24 hrs. Nat. _____

1st 24 hrs. after shot _____

Gas _____ Cu. Ft.

Dry Hole _____

Abandoned _____

Date

JUN 2 8 1950 19

J. E. TYRA Scout

FORM 275 FOR SALE BY KANSAS BLUE PRINT CO.

County Stevens State Kansas

Sec. 22 (Blk. Twp.) 32 (Sur. Rge.) 39W Map No.

Operator Panhandle Eastern

Well No. 1-22 Farm Jenkins

Elev. 3219 Location C NW/4



1320 Ft. From N Line NW

1318 Ft. From W Line Quarter

1st. Report

Completion AUG 3 0 1950

Remarks

Hugoton Pool

Spudding Date

Drlg. Data Gas well TD 2608

10" @ 557 7" @ 2394 TD 2404

Hol. 2360 Her. 2398 Krider 2422

Win. 2498 Ft. Riley 2569 TD 2608

Comp. 5,670,000 gas

J. E. TYRA