FORM 51 10M 12-46 PETROL


KANSAS

Morton county

Section 29 Township 32 Range 39-W

Well No. #1 Werhahn

Company Stanolind

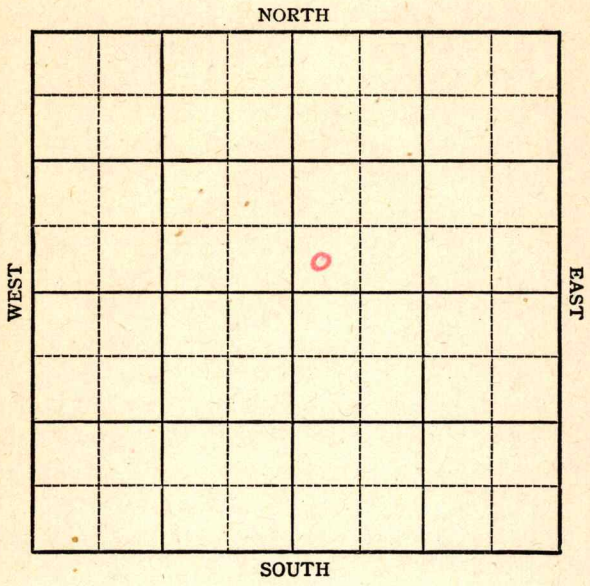

FORM 252-A
5M 12-46 PETROL KANSAS Morton ✔

Sec. 29 Twp. 32 R. 39-W

Well No. #1 Werhahn Farm

Stanolind Company

Hugoton Pool


____ Ft. from N. Line

100 Ft. from S. Line

____ Ft. from E. Line

100 Ft. from W. Line

SW NE

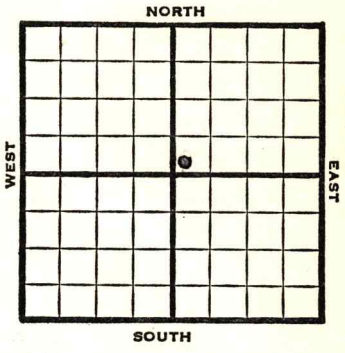

REPORT

1947	Elev. 3175
2/5	8" @ 518' Drlg 2570'
2/12	2570' fsg
2/19	2580' TD 5" @ 2548' RUST
2/26	500 Acid 214 shots 2488-2512'
3/5	5" @ 2548 Perf 18,000 Acid 11,390,000 Gas 303# R Pr TD 2580'

COMPLETED

Form 26 200 Bks. 10-46 Petrol

Kansas

Hugoton Pool

Map No. _____ Sec. 29 Twp. 32 R. 39W


Well No. 1 Werhahn

Stanolind Company

FIRST REPORT Contractor

SW NE

SECTION PLAT

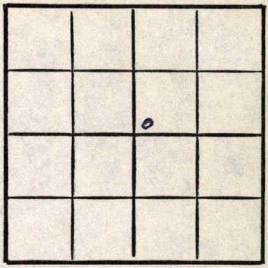

_____ Ft. from N. Line

100 Ft. from S. Line

_____ Ft. from E. Line

100 Ft. from W. Line

Morton County

Location _____

Rig up _____

Drilling and Remarks:

8" @ 518
drlg. 2570

RECORD

Cased _____ in., _____ ft.

Sand _____

Gas _____

Oil _____

Total Depth _____

PRODUCTION

1st 24 hrs. Nat. _____

1st 24 hrs. after shot _____

Gas _____ Cu. Ft.

Dry Hole _____

Abandoned _____

Date

FEB 5 1947 19

S. J. LEWIS Scout

Form 26 200 Bks. 10-46 Petrol KANSAS Hugoton Pool
Kansas

Map No. _____ Sec. 29 Twp. 32 R. 39W

Well No. 1 Werhahn


Stanolind Company

COMPLETE Contractor

SW NE

E 1,3175

SECTION PLAT

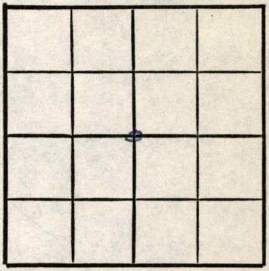

_____ Ft. from N. Line

100 Ft. from S. Line

_____ Ft. from E. Line

100 Ft. from W. Line

Morton County

Location _____

Rig up _____

Drilling and Remarks:

5" C 2547

Perf.

15000 acid

11,390,000 Gas

203 RP

RECORD

Cased _____ in., _____ ft.

Sand _____

Gas _____

Oil _____

Total Depth 2580

PRODUCTION

1st 24 hrs. Nat. _____

1st 24 hrs. after shot _____

Gas _____ Cu. Ft.

Dry Hole _____

Abandoned _____

Date

MAR 5. 1947 19

S. J. LEWIS Scout