

KANSAS

Stevens

FORM 51 IOM 12-46 PETROL

25

Section 24 Township 32 Range 39-W

Well No. #1 Shafer


Company Panhandle Eastern

Hugoton Pool

NORTH

WEST

EAST

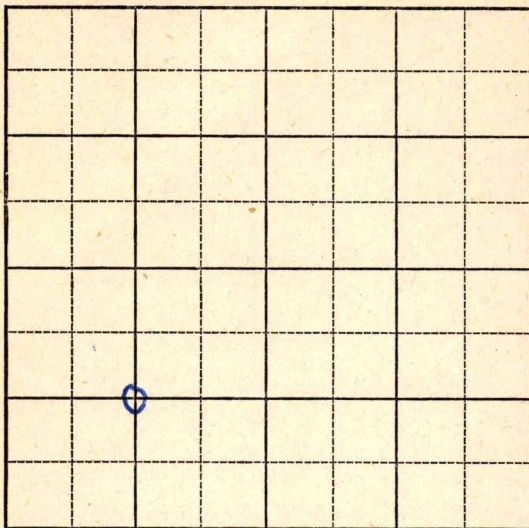

SOUTH

KANSAS

Stevens County ✓

Sec. 25 Twp. 32 R. 39-W

Well No. 1 Shafer Farm

Panhandle Eastern Company

Hugoton Pool


1320 Ft. from N. Line

_____ Ft. from S. Line

_____ Ft. from E. Line

1320 Ft. from W. Line

C SW

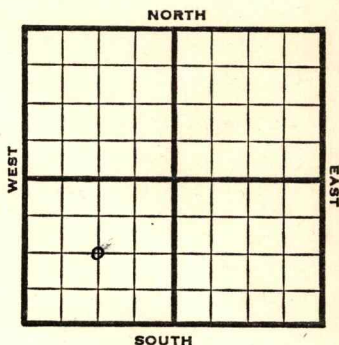

1947

Elev. 3212' REPORT

8/20	RUR Deep Test
8/27	16" @ 634' WOC
9/3	"
9/10	Drlg. 2523'
9/17	Fishing.
9/24	"
10/1	Drlg. 2865'
10/8	10" @ 3263' Drlg. 3270' Krider 2445'' Winfield 2509' Ft Riley 2588'
10/15	Drlg. 3908'
10/22	Drlg. 4282'
10/29	Drlg. 4685'
11/5	Drlg. 5240'
11/12	Drlg. 5771'
11/19	Drlg. 6198'

OVER

1947

11/25 Drlg. 6198'

12/3 Drlg. 6637'

12/30 Lansing 4048'
Viola 6886'
Simpson 7016'
Arbuckle 7086'
TD 7143'

1948

1/7

"

1/14 TD 7149'

1/21

"

1/26

"

2/4

"

2/11

"

2/18

"

2/25

"

3/3

Arbuckle 7086'

Total Depth 7149'


ABANDONED

Map No. _____ Sec. 25 Twp. 3 2 R. 39WWell No. 1 ShaferPanhandle Eastern CompanyFIRST REPORT

Contractor

C SW

SECTION PLAT

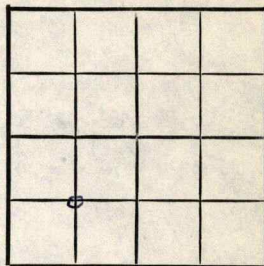1320 Ft. from N. Line

_____ Ft. from S. Line

_____ Ft. from E. Line

1320 Ft. from W. LineStevens County

Location _____

Rig up _____

Drilling and Remarks:

R U R

Deep test

RECORD

Cased _____ in., _____ ft.

Sand _____

Gas _____

Oil _____

Total Depth _____

PRODUCTION

1st 24 hrs. Nat. _____

1st 24 hrs. after shot _____

Gas _____ Cu. Ft.

Dry Hole _____

Abandoned _____

Date

AUG 20 1947

19

S. J. LEWIS

Scout

No Map
Map No. _____ Sec. 25 Twp. 32 R. 39W

Well No. 1 Shafer

Panhandle Eastern Company


ABANDONED

Contractor

C SW

E1.3212

SECTION PLAT

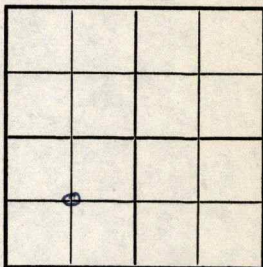

1320 Ft. from N. Line

_____ Ft. from S. Line

_____ Ft. from E. Line

1320 Ft. from W. Line

Stevens County

Location _____

Rig up _____

Drilling and Remarks:

Ar 82086

RECORD

Cased _____ in., _____ ft.

Sand _____

Gas _____

Oil _____

Total Depth 7149

PRODUCTION

1st 24 hrs. Nat. _____

1st 24 hrs. after shot _____

Gas _____ Cu. Ft.

Dry Hole _____

Abandoned _____

Date

MAR 3 1948

19

S. J. LEWIS Scout