


Section 26 Township 32 Range 39-W

Well No. 1 - Stecher

Company Panhandle Eastern

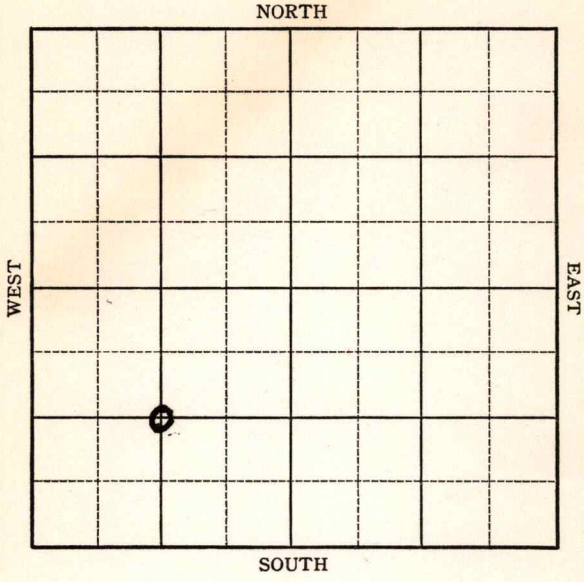


KANSAS

Stevens

Sec. 26 Twp. 32 R. 39-WWell No. #1 Stecher FarmPanhandle Eastern Company Ft. from N. Line1320 Ft. from S. Line Ft. from E. Line1320 Ft. from W. Line

Elev. 3182

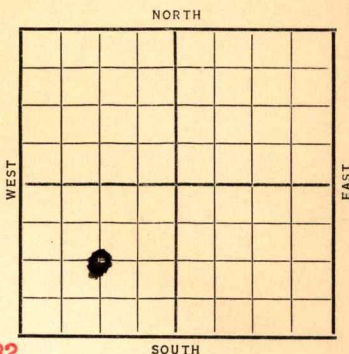

Date	REPORT
1937	
5/26	Location
6/4	"
6/11	10" @ 505'. WOC.
6/19	" " "
6/25	7" @ 2466'. WOC.
7/2	" " "
7/9	" " "
7/16	" " "
7/23	" " "
7/30	" " "
8/4	7" @ 2466'.
	Sand 2466'.
	T. D. 2800'.
	P.B. 2606'.
	3½ M gas.
	COMPLETED

Stevens **KANSAS**Map No. _____ Sec. 26 Twp. 32 R. 39^WWell No. 1 - Stecher
Panhandle Eastern Company

Contractor _____

FIRST REPORT

SECTION PLAT

_____ Ft. from N. Line

1320 Ft. from S. Line

_____ Ft. from E. Line

1320 Ft. from W. LineLocation ✓ _____

Rig up _____

Drilling and Remarks: _____

RECORD

Cased _____ in., _____ ft.

Sand _____

Gas _____

Oil _____

Total Depth _____

PRODUCTION

1st 24 hrs. Nat. _____

1st 24 hrs. after shot _____

Gas _____ Cu. Ft.

Dry Hole _____

Abandoned _____

Date

MAY 26 1937 19

H. D. Hatfield

Scout

Stevens **KANSAS**Map No. _____ Sec. 26 Twp. 32 R. 39 ^WWell No. 1-SteicherPanhandle Eastern Company

Contractor _____

COMPLETED

SECTION PLAT

_____ Ft. from N. Line

1320 Ft. from S. Line

_____ Ft. from E. Line

1320 Ft. from W. Line

Location _____

Rig up _____

Drilling and Remarks:

*P.B. 2606**3 1/2 M. gas*

RECORD

Cased 7 in., 2466 ft.Sand 2466

Gas _____

Oil _____

Total Depth 2800

PRODUCTION

1st 24 hrs. Nat. _____

1st 24 hrs. after shot _____

Gas _____ Cu. Ft.

Dry Hole _____

Abandoned _____

Date

AUG 4 - 1937 19H. D. Hatfield Scout